

PIKE
B. 2028
7/31/80

MISSISSIPPI
 BOARD OF WATER COMMISSIONERS
 416 North State Street
 Jackson, Mississippi 39201

WATER WELL DRILLERS LOG

July 31 1980 News Well Pike
 date well completed firm name county well located


LANDOWNER:
Catherine Smith
Rt Summit
 (mailing address)

description of formations encountered	from	to
<u>clay</u>	<u>0</u>	<u>21</u>
<u>red sand</u>	<u>21</u>	<u>90</u>
<u>red chalk & sand</u>	<u>90</u>	<u>103</u>
<u>big gravel</u>	<u>103</u>	<u>135</u>

WELL LOCATION:
 sec. 12 T 4 N R 8 E
2 1/2 miles W NW of Felder Comp
 (distance) (direction) (nearest town)

WELL PURPOSE: new house
 (home, irrigation, municipal, industrial)

- WELL COMPLETION DATA:
- diameter (inches) 4"
 - total depth (feet) 135
 - static water level (feet) 100 below above top of ground.
 - casing plastic bottom
 (material) (depth)
 (size) if telescope see back.
 - screen 5' 130'
 (length) (depth to top)
4" plastic
 (size) (material)
 - pump 2 1/2 10
 (HP) (yield gpm)
elect
 (type power)
 - electric log no
 (yes or no)
 (organization running log)
 - how well bottom plugged rock at bottom

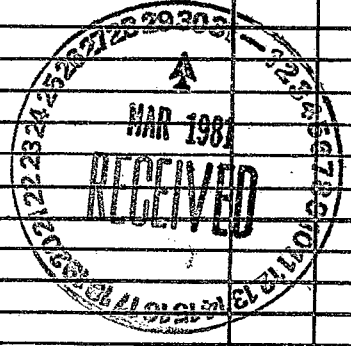

DRILLERS REMARKS:
/

