

Pike
B 2029
11/12/81

MISSISSIPPI
BOARD OF WATER COMMISSIONERS
416 North State Street
Jackson, Mississippi 39201

WATER WELL DRILLERS LOG

11-12
date well completed

81 Fitzgerald Well Co
firm name

Pike
county well located

LANDOWNER:	description of formations encountered	from	to
A. R. Halliburton	Reel Clay	0	20
P.R. Summit Ins. (mailing address)	Reel Sand Coarse sand & gravel	20 50	50 61
WELL LOCATION:			
sec. 36 T. 4 N R. 8 E 6 miles NE of McComb (distance) (direction) (nearest town)			
WELL PURPOSE: (home, irrigation, municipal, industrial)			
WELL COMPLETION DATA:			
(1) diameter (inches) 4			
(2) total depth (feet) 61			
(3) static water level (feet) 25 below top of ground.			
(4) casing PVC 53 (material) (depth)			
4 (size) if telescope see back.			
(5) screen 8 53 (length) (depth to top)			
4 (size) PVC (material)			
(6) pump 1/2 10 (HP) (yield gpm)			
Els (type power)			
(7) electric log No (yes or no)			
(organization running log)			
(8) how well bottom plugged L.H.H.			
DRILLERS REMARKS:			


DEPT. OF NATURAL RESOURCES
BUREAU OF LAND & WATER RESOURCES

NOV 20 1981

RECEIVED

If well telescopes please
sketch and show depths.

GROUND LEVEL

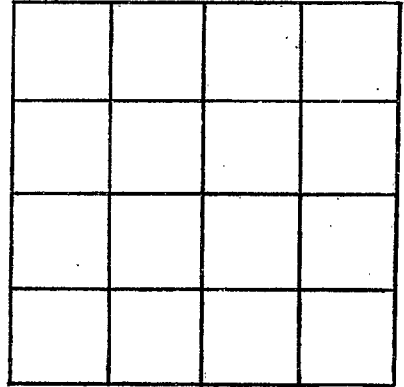

SECTION 3C

Please indicate well location X.

ADDITIONAL INFORMATION

If more than one screen,
show locations of each on sketch.