

Pike  
B 2030  
8-29-81

MISSISSIPPI  
 BOARD OF WATER COMMISSIONERS  
 416 North State Street  
 Jackson, Mississippi 39201

WATER WELL DRILLERS LOG

8-29

date well completed

Steele well Inc

firm name


Pike

county well located

LANDOWNER:	description of formations encountered	from	to
<u>A. Dixon</u>			
<u>RR. Summits</u> (mailing address)	<u>Red clay</u> <u>Red sand</u> <u>Coarse sand</u>	<u>0</u> <u>20</u> <u>90</u>	<u>20</u> <u>90</u> <u>110</u>
<b>WELL LOCATION:</b>			
sec. <u>10</u> T. <u>4</u> <u>N</u> R. <u>8</u> <u>E</u> S W			
<u>7</u> miles <u>NE</u> of <u>Summit</u> (distance) (direction) (nearest town)			
<b>WELL PURPOSE:</b> <u>Home</u> (home, irrigation, municipal, industrial)			
<b>WELL COMPLETION DATA:</b>			
(1) diameter (inches) <u>4</u>			
(2) total depth (feet) <u>110</u>			
(3) static water level (feet) <u>70</u> below above top of ground.			
(4) casing <u>PVC</u> , <u>102</u> , (material) (depth) <u>4</u> (size) if telescope see back.			
(5) screen <u>8</u> , <u>102</u> (length) (depth to top)			
<u>4</u> , <u>PVC</u> (size) (material)			
(6) pump <u>1/2</u> , <u>10</u> (HP) (yield gpm) <u>elec</u> (type power)			
(7) electric log <u>no</u> (yes or no)			
(organization running log)			
(8) how well bottom plugged <u>Substr.</u>			
<b>DRILLERS REMARKS:</b>			

If well telescopes please sketch and show depths.

GROUND LEVEL

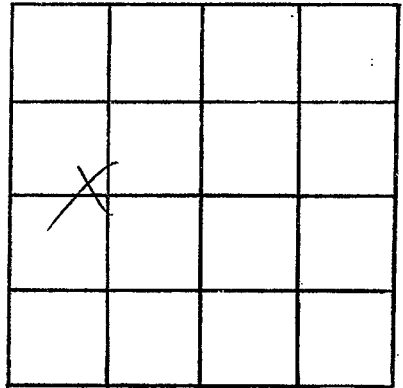

SECTION 10

Please indicate well location X.

ADDITIONAL INFORMATION

Lined area for additional information.

If more than one screen, show locations of each on sketch.

DEPT. OF NATURAL RESOURCES  
BUREAU OF LAND & WATER RESOURCES  
SEP 28 1981  
RECEIVED