

Pike
B 2032
10-12-81

MISSISSIPPI
BOARD OF WATER COMMISSIONERS
416 North State Street
Jackson, Mississippi 39201

WATER WELL DRILLERS LOG

10-12 1981 *J. G. ...* Pike
date well completed firm name county well located

LANDOWNER:	description of formations encountered	from	to
<i>Pete ...</i>			
<i>R.R. ...</i> (mailing address)	<i>Reel clay</i>	0	20
	<i>Reel sand</i>	20	170
	<i>Coarse sand & gravel</i>	170	181

WELL LOCATION:
sec. 24 T 4 N R 8 E
S W
8 miles NE of MCMB
(distance) (direction) (nearest town)

WELL PURPOSE: Home
(home, irrigation, municipal, industrial)

- WELL COMPLETION DATA:
- (1) diameter (inches) 4
 - (2) total depth (feet) 189
 - (3) static water level (feet) 110 below above top of ground.
 - (4) casing 206, 181,
(material) (depth)
+ if telescope see back.
(size)
 - (5) screen 8, 181
(length) (depth to top)
4, 206
(size) (material)
 - (6) pump 3/4, 15
(HP) (yield gpm)
elec
(type power)
 - (7) electric log no
(yes or no)
...
(organization running log)
 - (8) how well bottom plugged ...


DRILLERS REMARKS:

DEPT. OF NATURAL RESOURCES
BUREAU OF LAND & WATER RESOURCES

NOV 20 1981
RECEIVED

If well telescopes please sketch and show depths.

GROUND LEVEL

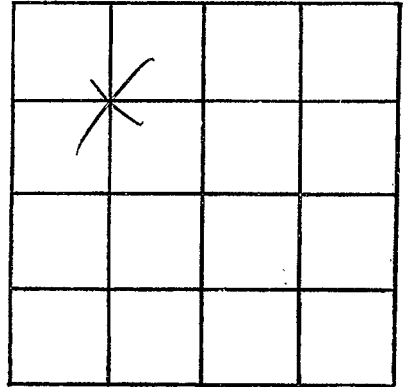

SECTION 24

Please indicate well location X.

ADDITIONAL INFORMATION

If more than one screen,
show locations of each on sketch.