

MISSISSIPPI DEPARTMENT OF NATURAL RESOURCES

Bureau of Land and Water Resources

Southport Mall

P.O. Box 10631

Jackson, Mississippi 39209

WATER WELL DRILLERS LOG

| |
|---------|
| PIKE |
| 8 2033 |
| 6/20/81 |

Date well completed June 20 19 81 firm name Reverly Well Pipe county well located _____

LANDOWNER:
John Benkeris
Rt Summit
(mailing address)

| description of formations encountered | from | to |
|---------------------------------------|-----------|-----------|
| <u>Clay & gravel</u> | <u>0</u> | <u>27</u> |
| <u>Siltstone</u> | <u>27</u> | <u>45</u> |
| <u>Gravel</u> | <u>45</u> | <u>54</u> |

WELL LOCATION:
sec. 19 T. 9 N. R. 8 E
1 1/2 miles east of Summit
(distance) (direction) (nearest town)

WELL PURPOSE: Trailer
(home, irrigation, municipal, industrial)

- WELL COMPLETION DATA:
- (1) diameter (inches) 4"
 - (2) total depth (feet) 54
 - (3) static water level (feet) 30' below above top of ground.
 - (4) casing Plastic bottom
(material) (depth)
 - _____ if telescope see back.
(size)
 - (5) screen 5' 49'
(length) (depth to top)
 - 4" Plastic
(size) (material)
 - (6) pump 1/2 10
(HP) (yield gpm)
 - split
(type power)
 - (7) electric log no
(yes or no)
 - ✓
(organization running log)

(8) how well bottom plugged Repacked

DRILLERS REMARKS: _____


DEPT. OF NATURAL RESOURCES
BUREAU OF LAND & WATER RESOURCES

JAN 4 - 1982

RECEIVED

If well telescopes please
sketch and show depths.

GROUND LEVEL

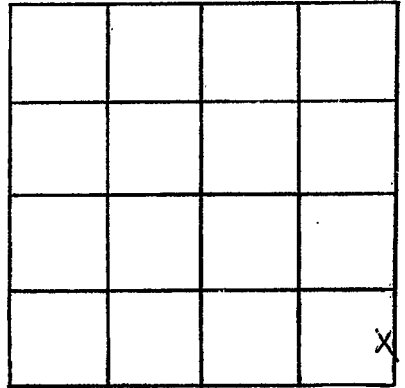

SECTION 10

Please indicate well location X.

ADDITIONAL INFORMATION

If more than one screen,
show locations of each on sketch.