

MISSISSIPPI DEPARTMENT OF NATURAL RESOURCES

Bureau of Land and Water Resources

Southport Mall

P.O. Box 10631

Jackson, Mississippi 39209

WATER WELL DRILLERS LOG

PIKE
B 2034
6/10/81

June 10 1981 News Well Dr. Pipe  
 date well completed firm name county well located

LANDOWNER:	description of formations encountered	from	to
James Ard Mt Summit (mailing address)			
WELL LOCATION: sec. 14 T 4(N) R 8(E) 3 miles west of Falders Camp (distance) (direction) (nearest town)			
WELL PURPOSE: home (home, irrigation, municipal, industrial)			
WELL COMPLETION DATA:			
(1) diameter (inches) 4"			
(2) total depth (feet) 117			
(3) static water level (feet) 66 /below top of ground.			
(4) casing plastic bottom (material) (depth)			
(size) If telescope see back.			
(5) screen 5' 112' (length) (depth to top)			
4" plastic (size) (material)			
(6) pump by others (HP) (yield gpm)			
1/2 HP (type power)			
(7) electric log no (yes or no)			
(organization running log)			
(8) how well bottom plugged back with sand			

DRILLERS REMARKS:  
C


DEPT. OF NATURAL RESOURCES  
BUREAU OF LAND & WATER RESOURCES

JAN 4 - 1982

RECEIVED

If well telescopes please sketch and show depths.

GROUND LEVEL

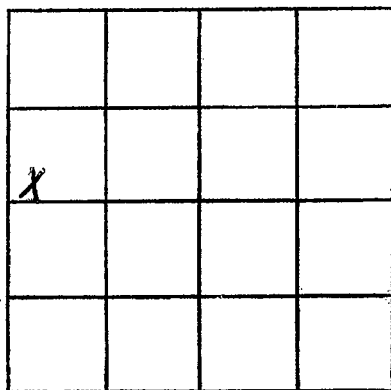

SECTION 14

Please indicate well location X.

ADDITIONAL INFORMATION

If more than one screen, show locations of each on sketch.