

MISSISSIPPI DEPARTMENT OF NATURAL RESOURCES

Bureau of Land and Water Resources

Southport Mall

P.O. Box 10631

Jackson, Mississippi 39209

WATER WELL DRILLERS LOG

Pike
B
2035

3-1
date well completed

1982 Reuss well Pike
firm name county well located

LANDOWNER:

W. R. (Bill) Matt
Rt Summit
(mailing address)

description of formations encountered

from

to

<u>Red sand & clay</u>	<u>0</u>	<u>30</u>
<u>brown sand</u>	<u>30</u>	<u>50</u>
<u>gravel sand</u>	<u>50</u>	<u>65</u>
<u>pink chalk</u>	<u>65</u>	<u>90</u>
<u>shale</u>	<u>90</u>	<u>120</u>
<u>coarse sand</u>	<u>120</u>	<u>138</u>

WELL LOCATION:

sec. 7 T. 4 N R. SE
3 miles N. NE of Summit
(distance) (direction) (nearest town)

WELL PURPOSE: home
(home, irrigation, municipal, industrial)

WELL COMPLETION DATA:

- (1) diameter (inches) 4"
- (2) total depth (feet) 138
- (3) static water level (feet) 80 below top of ground.
- (4) casing plaster bottom
(material) (depth)
- (size) if telescope see back.
- (5) screen 5' 133'
(length) (depth to top)
- (size) 4" plaster
(material)
- (6) pump 3 sub 12
(HP) (yield gpm)
- (type power) elect
- (7) electric log no
(yes or no)
- (organization running log)

(8) how well bottom plugged
back water

DRILLERS REMARKS:


DEPT. OF NATURAL RESOURCES
BUREAU OF LAND & WATER RESOURCES

JUL 15 1982

RECEIVED

If well telescopes please sketch and show depths.

GROUND LEVEL

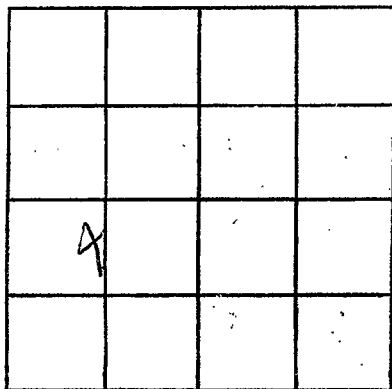

SECTION X

Please indicate well location X.

ADDITIONAL INFORMATION

If more than one screen,
show locations of each on sketch.