

MISSISSIPPI DEPARTMENT OF NATURAL RESOURCES

Bureau of Land and Water Resources

Southport Mall

P.O. Box 10631

Jackson, Mississippi 39209

WATER WELL DRILLERS LOG

<u>Pike</u>
<u>B 20320</u>

April 27 1982  
date well completed

Reverella  
firm name

Pike  
county well located

LANDOWNER:  
Jimmy Johnston  
Rt 1 McComb  
(mailing address)

description of formations encountered	from	to
<u>clay</u>	<u>0</u>	<u>12</u>
<u>brown sand</u>	<u>12</u>	<u>30</u>
<u>White Chalk</u>	<u>30</u>	<u>65</u>
<u>fine Chalky Sand</u>	<u>65</u>	<u>115</u>
<u>Coarse Sand</u>	<u>115</u>	<u>130</u>

WELL LOCATION:  
sec. 33 T 4 N R 8 E  
3 miles east of Summit  
(distance) (direction) (nearest town)

WELL PURPOSE: Camp  
(home, irrigation, municipal, industrial)

WELL COMPLETION DATA:

- (1) diameter (inches) 4"
- (2) total depth (feet) 130
- (3) static water level (feet) 45 below top of ground.
- (4) casing plastic bottom  
(material) (depth)
- (size)   if telescope see back.
- (5) screen 5' 125'  
(length) (depth to top)
- (size) 4" (material) plastic
- (6) pump 3/4 12  
(HP) (yield gpm)
- (type power) electric
- (7) electric log no  
(yes or no)
- (organization running log)
- (8) how well bottom plugged post wash

DRILLERS REMARKS:  
 


DEPT. OF NATURAL RESOURCES  
BUREAU OF LAND & WATER RESOURCES

AUG - 5 1982

RECEIVED

If well telescopes please  
sketch and show depths.

GROUND LEVEL

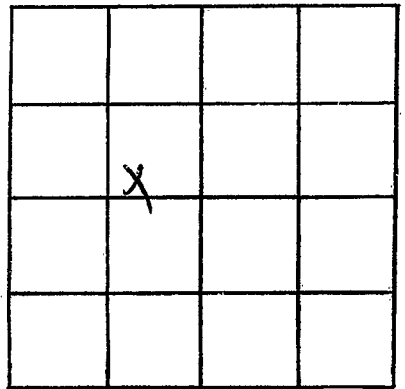

SECTION 33

Please indicate well location X.

ADDITIONAL INFORMATION

If more than one screen,  
show locations of each on sketch.