

MISSISSIPPI DEPARTMENT OF NATURAL RESOURCES

Bureau of Land and Water Resources

Southport Mall

P.O. Box 10631

Jackson, Mississippi 39209

WATER WELL DRILLERS LOG

Pike
B
2040

1-20
 date well completed

19*84* *Fitzgerald well Co*
 firm name

Pike
 county well located

LANDOWNER:	description of formations encountered	from	to
BAKIN <i>P.B. Tipton, ms.</i> (mailing address)	<i>Red clay</i> <i>white chalk</i> <i>Coarse sand & gravel</i>	<i>0</i> <i>20</i> <i>130</i>	<i>20</i> <i>130</i> <i>150</i>
WELL LOCATION: sec. <i>2</i> T <i>4</i> N R <i>8</i> E S W <i>8</i> miles <i>W</i> of <i>Tipton</i> (distance) (direction) (nearest town)			
WELL PURPOSE: <i>flow</i> (home, irrigation, municipal, industrial)			
WELL COMPLETION DATA: (1) diameter (inches) <i>4</i> (2) total depth (feet) <i>150</i> (3) static water level (feet) <i>110</i> below above top of ground. (4) casing <i>PVC 142</i> (material) (depth) <i>4</i> if telescope see back. (size) (5) screen <i>8 142</i> (length) (depth to top) <i>4</i> <i>PVC</i> (size) (material) (6) pump <i>1/2 10</i> (HP) (yield gpm) <i>flow</i> (type power) (7) electric log <i>no</i> (yes or no) (organization running log) (8) how well bottom plugged <i>full</i>			

DRILLERS REMARKS:


DEPT. OF NATURAL RESOURCES
 BUREAU OF LAND & WATER RESOURCES

MAR - 8 1984

RECEIVED

If well telescopes please sketch and show depths.

GROUND LEVEL

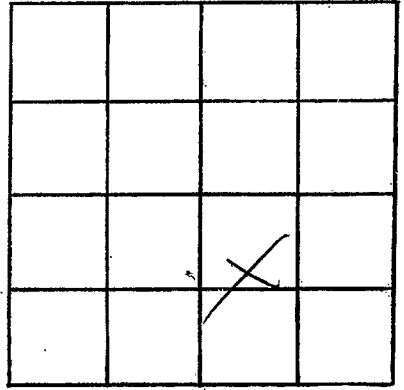

SECTION 2

Please indicate well location X.

ADDITIONAL INFORMATION

If more than one screen,
show locations of each on sketch.