

MISSISSIPPI DEPARTMENT OF NATURAL RESOURCES

Bureau of Land and Water Resources

Southport Mall

P.O. Box 10631

Jackson, Mississippi 39209

WATER WELL DRILLERS LOG

Pike  
B  
2042

2-29 1984  
date well completed

Alzoukhalil  
firm name

Pike  
county well located

LANDOWNER:	description of formations encountered	from	to
<u>Rodger Elbridge</u>			
<u>R.R. Summit, Jr.</u> (mailing address)	<u>Red clay</u>	<u>2</u>	<u>20</u>
	<u>Red Sand</u>	<u>20</u>	<u>80</u>
	<u>Coarse Sand &amp; gravel</u>	<u>80</u>	<u>95</u>

WELL LOCATION:  
sec. 5 T. 4 N R. 8 E  
S W  
8 miles NE of Summit  
(distance) (direction) (nearest town)

WELL PURPOSE:  
(home, irrigation, municipal, industrial)

- WELL COMPLETION DATA:
- (1) diameter (inches) 4
  - (2) total depth (feet) 95
  - (3) static water level (feet) 40 below top of ground.
  - (4) casing PVC, 87,  
(material) (depth)  
4 if telescope see back.  
(size)
  - (5) screen 8, 87  
(length) (depth to top)  
4, PVC  
(size) (material)
  - (6) pump 1/2, 10  
(HP) (yield gpm)  
EL  
(type power)
  - (7) electric log no  
(yes or no)  
(organization running log)
  - (8) how well bottom plugged Full

DRILLERS REMARKS:


DEPT. OF NATURAL RESOURCES  
BUREAU OF LAND & WATER RESOURCES

MAR - 7 1984

RECEIVED

If well telescopes please  
sketch and show depths.

GROUND LEVEL

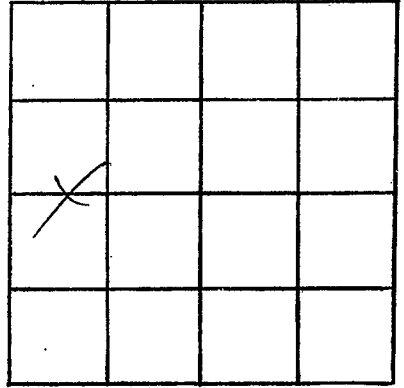

SECTION 5

Please indicate well location X.

ADDITIONAL INFORMATION

If more than one screen,  
show locations of each on sketch.