

MISSISSIPPI DEPARTMENT OF NATURAL RESOURCES

Bureau of Land and Water Resources

Southport Mall

P.O. Box 10631

Jackson, Mississippi 39209

WATER WELL DRILLERS LOG

PIKE
B
2043

3-23

date well completed

1984 Fitzgerald Well Serv

firm name

Pike

county well located

LANDOWNER:

David Price

description of formations encountered

from

to

R.R. Summit, ms -
(mailing address)

Red clay	0	20
Red gravel	20	140
Coarse sand & gravel	140	158

WELL LOCATION:

sec. 5 T. 4 N. R. 8 E.
S W

6 miles NE of Summit
(distance) (direction) (nearest town)

WELL PURPOSE:

(home, irrigation, municipal, industrial)

Home

WELL COMPLETION DATA:

- (1) diameter (inches) 4
- (2) total depth (feet) 158
- (3) static water level (feet) 95 below top of ground.

- (4) casing PVC, 150, (material) (depth)

4 (size) if telescope see back.

- (5) screen 8, 150 (length) (depth to top)

4 (size) PVC (material)

- (6) pump 1/2 (HP) 10 (yield gpm)

el (type power)

- (7) electric log (yes or no)

(organization running log)

- (8) how well bottom plugged Seal the

DRILLERS REMARKS:


DEPT. OF NATURAL RESOURCES
BUREAU OF LAND & WATER RESOURCES

APR 26 1984

RECEIVED

If well telescopes please
sketch and show depths.

GROUND LEVEL

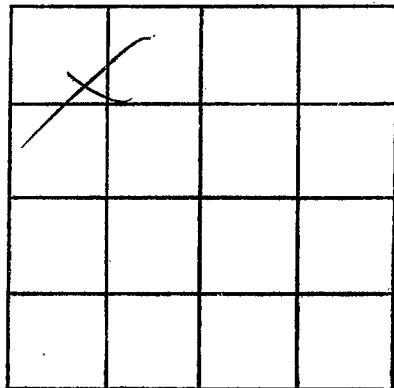

SECTION 5

Please indicate well location X.

ADDITIONAL INFORMATION

If more than one screen,
show locations of each on sketch.