

PIKE  
B  
2057

MISSISSIPPI DEPARTMENT OF NATURAL RESOURCES  
Bureau of Land and Water Resources  
Southport Mall  
P.O. Box 10631  
Jackson, Mississippi 39209  
WATER WELL DRILLERS LOG

9-17 1984 Grenn Water Well Pike  
date well completed firm name county well located

LANDOWNER: Shell Western  
Kelley=Coppedge, Inc.

description of formations encountered

from to

Citronelle

1 108

Box 175  
Brookhaven, Ms.  
(mailing address)

WELL LOCATION:

sec. 1 T 4 N 8 E  
S W  
9 miles NE of McComb  
(distance) (direction) (nearest town)

WELL PURPOSE: Industrial  
(home, irrigation, municipal, industrial)

WELL COMPLETION DATA:

- (1) diameter (inches) 4
- (2) total depth (feet) 108
- (3) static water level (feet) 68 below above top of ground.
- (4) casing PVC, 98'  
(material) (depth)  
4" if telescope see back.  
(size)
- (5) screen 10', 98'  
(length) (depth to top)  
.010 PVC  
(size) (material)
- (6) pump 1 1/2 sub 20  
(HP) (yield gpm)  
electricity  
(type power)
- (7) electric log no  
(yes or no)

(organization running log)

- (8) how well bottom plugged  
back wash valve

DRILLERS REMARKS:


MISSISSIPPI DEPARTMENT OF NATURAL RESOURCES  
BUREAU OF LAND & WATER RESOURCES

NOV 15 1984

RECEIVED

If well telescopes please sketch and show depths.

GROUND LEVEL

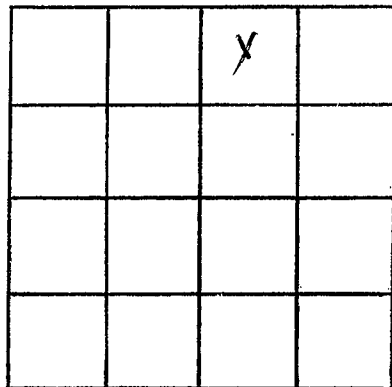

SECTION   /  

Please indicate well location X.

ADDITIONAL INFORMATION

If more than one screen,  
show locations of each on sketch.