

MISSISSIPPI DEPARTMENT OF NATURAL RESOURCES

Bureau of Land and Water Resources

Southport Mall

P.O. Box 10631

Jackson, Mississippi 39209

WATER WELL DRILLERS LOG

LINCOLN
PIKE
B 2063

9-19 1985
date well completed

Feltonland Sew
firm name

Lincoln
county well located

LANDOWNER:	description of formations encountered	from	to
<u>Charles O'Brien</u>			
<u>R.R. Summit ms.</u> (mailing address)	<u>Red clay</u>	<u>0</u>	<u>20</u>
	<u>Red sand</u>	<u>20</u>	<u>60</u>
	<u>Coarse sand & gravel</u>	<u>60</u>	<u>72</u>
WELL LOCATION: sec <u>33</u> T <u>4</u> N R <u>8</u> E S W			
<u>7</u> miles <u>NE</u> of <u>Summit</u> (distance) (direction) (nearest town)			
WELL PURPOSE: <u>Home</u> (home, irrigation, municipal, industrial)			
WELL COMPLETION DATA:			
(1) diameter (inches) <u>4</u>			
(2) total depth (feet) <u>72</u>			
(3) static water level (feet) <u>20</u> below top of ground.			
(4) casing <u>PVC</u> , <u>62</u> (material), (depth) <u>4</u> (size) If telescope see back.			
(5) screen <u>10</u> , <u>62</u> (length), (depth to top) <u>4</u> (size), <u>PVC</u> (material).			
(6) pump <u>1/2</u> , <u>10</u> (HP), (yield gpm) <u>Electric</u> (type power)			
(7) electric log <u>no</u> (yes or no) <u>no</u> (organization running log)			
(8) how well bottom plugged <u>hard plug</u>			
DRILLERS REMARKS:			


RECEIVED

NOV - 5 1985

Department of Natural Resources
Bureau of Land & Water Resources

If well telescopes please sketch and show depths.

GROUND LEVEL

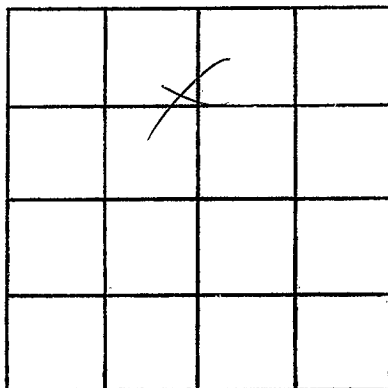

SECTION 33

Please indicate well location X.

ADDITIONAL INFORMATION

If more than one screen,
show locations of each on sketch.