

MISSISSIPPI DEPARTMENT OF NATURAL RESOURCES

Bureau of Land and Water Resources

Southport Mall

P.O. Box 10631


Jackson, Mississippi 39209

WATER WELL DRILLERS LOG

PIPE  
B 205

9-19 1985 F. G. Swell and Son Lincoln  
date well completed firm name county well located

LANDOWNER:	description of formations encountered	from	to
<u>Charles O'Brien</u>			
<u>RR. Summit ms.</u> (mailing address)	<u>Red clay</u>	<u>0</u>	<u>20</u>
	<u>Red sand</u>	<u>20</u>	<u>30</u>
	<u>Coarse sand &amp; gravel</u>	<u>30</u>	<u>64</u>
WELL LOCATION:			
sec. <u>33</u> T <u>4</u> N R <u>8</u> E S W			
<u>7 1/4</u> miles <u>NE</u> of <u>Summit</u> (distance) (direction) (nearest town)			
WELL PURPOSE:			
<u>Home</u> (home, irrigation, municipal, industrial)			
WELL COMPLETION DATA:			
(1) diameter (inches) <u>4</u>			
(2) total depth (feet) <u>64</u>			
(3) static water level (feet) <u>25</u> below top of ground.			
(4) casing <u>PVC</u> , <u>54</u> (material) (depth) <u>4</u> if telescope see back. (size)			
(5) screen <u>10</u> , <u>54</u> (length) (depth to top) <u>4</u> , <u>PVC</u> (size) (material)			
(6) pump <u>1/2</u> , <u>10</u> (HP) (yield gpm) <u>elec</u> (type power)			
(7) electric log <u>no</u> (yes or no) <u>Summit</u> (organization running log)			
(8) how well bottom plugged <u>Sand blk</u>			

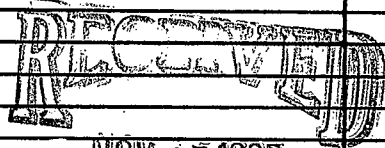


DRILLERS REMARKS:

Department of Natural Resources  
Bureau of Land & Water Resources

If well telescopes please sketch and show depths.

GROUND LEVEL

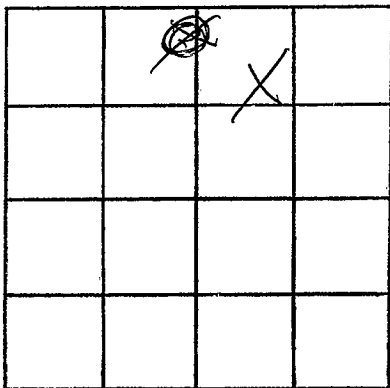

SECTION 33

Please indicate well location X.

ADDITIONAL INFORMATION

If more than one screen,  
show locations of each on sketch.