

PIKE
B
2056

MISSISSIPPI DEPARTMENT OF NATURAL RESOURCES
Bureau of Land and Water Resources
Southport Mall
P.O. Box 10631
Jackson, Mississippi 39209
WATER WELL DRILLERS LOG

6-24 1986 Edwards Well Sew Pike
date well completed firm name county well located

LANDOWNER: Chris Bryant
R.R. 1, Summit
(mailing address)

description of formations encountered	from	to
<u>Red clay</u>	<u>0</u>	<u>20</u>
<u>Red sand</u>	<u>20</u>	<u>32</u>
<u>Coarse sand & gravel</u>	<u>32</u>	<u>80</u>

WELL LOCATION:
sec. 15 T 4 N R 8 E
S W
6 miles E of Summit
(distance) (direction) (nearest town)

WELL PURPOSE: Domestic
(home, irrigation, municipal, industrial)

- WELL COMPLETION DATA:
- (1) diameter (inches) 4
 - (2) total depth (feet) 80
 - (3) static water level (feet) 18 below above top of ground.
 - (4) casing pvc, 64,
(material), (depth)
4 if telescope see back.
(size)
 - (5) screen 16, 64
(length), (depth to top)
4, pvc
(size), (material)
 - (6) pump 1 24
(HP), (yield gpm)
elec
(type power)
 - (7) electric log No
(yes or no)
(organization running log)
 - (8) how well bottom plugged Seal off


RECEIVED
BUREAU OF LAND & WATER RESOURCES
JUL 21 1986

Department of Natural Resources
Bureau of Land & Water Resources

DRILLERS REMARKS:

If well telescopes please sketch and show depths.

GROUND LEVEL

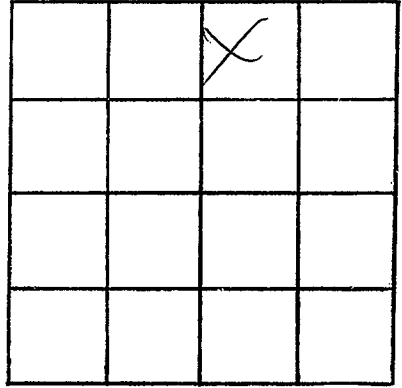

SECTION 15

Please indicate well location X.

ADDITIONAL INFORMATION

If more than one screen,
show locations of each on sketch.