

MISSISSIPPI DEPARTMENT OF NATURAL RESOURCES

Bureau of Land and Water Resources

P.O. Box 10631

Jackson, Mississippi 39209

WATER WELL DRILLERS LOG

COUNTY WELL LOCATED <i>Pike</i>	
WELL NUMBER <i>3</i>	CODED
DATE WELL COMPLETED <i>2063</i> <i>11-14-88</i>	

PERMIT NUMBER
NAME OF DRILLING FIRM <i>Green Water Well & Supply, Inc.</i>

NAME & MAILING ADDRESS OF LANDOWNER <i>Keith Sanders</i>			
<i>P.O. Box 1388</i>			
<i>Jacobson, Inc.</i>			
WELL LOCATION:	SEC	TOWNSHIP	RANGE
	<i>16</i>	<i>4</i>	<i>8</i> ^N / _S ^E / _W
DISTANCE	DIRECTION	NEAREST TOWN	
<i>8</i> Miles	<i>E</i>	of <i>Summit</i>	
OTHER LANDMARK			
WELL PURPOSE: Home, Irrigation, Municipal, Industrial, Fish Pond, etc. <i>Camp</i>			

PUMP DATA		
PUMP TYPE (Circle One): Submersible, Turbine, Jet, Flowing Well, Other (Describe) <u><i>Did not install</i></u>		
POWER TYPE (Circle One): Electric, Tractor, Diesel, Gasoline, Butane, Other (Describe) _____ H/P _____		
Pump Capacity (GPM)	No. of Stages	Setting Depth FT.
PUMP TEST: Well yielded <i>14</i> GPM with a drawdown of <i>0</i> ft. after <i>2</i> hours of pumping		

WELL DATA		
Well Depth <i>53</i>	Casing Diameter (In.) <i>4</i>	Casing Length (Ft.) <i>43</i>
Type of Casing <i>PVC</i>	Hole Depth <i>60</i>	Depth to Static Water Level <i>12</i>
TYPE OF COMPLETION: (Circle One or More): <input checked="" type="checkbox"/> Gravel Packed, <input type="checkbox"/> Underreamed, <input type="checkbox"/> Telescoped, <input type="checkbox"/> Natural Development, <input type="checkbox"/> Open Hole, <input type="checkbox"/> Other (Describe) _____		
Top of Lap Pipe or Reduction in Casing FEET <input type="checkbox"/> IF TELESCOPED OR MORE THAN ONE SCREEN: USE BACK PAGE		

LOG DATA	
TYPE OF LOG RUN (Circle One): Electric, Gamma Ray, Density, Sonic, Neutron, Other (Describe) _____	
<input checked="" type="checkbox"/> No Log Run	
Name of Organization Running Log	

SCREEN DATA		
Diameter - Inches <i>4</i>	Length - Feet <i>10</i>	Slot Size - Inches <i>10/16</i>
Screen Type <i>PVC</i>	Depth to Bottom - Feet <i>53</i>	

GEOLOGIC DATA (Office Use Only)			
Surface Elev.	Geologic Unit	Unit Thickness	Depth to Top
Subs. SWL	Date	Analysis	Aquifer Test
Driller's Remarks			

DESCRIPTION OF FORMATIONS ENCOUNTERED	FROM	TO	FORMATIONS (Continued)	
			FROM	TO
<i>Citronelle</i>	<i>0</i>	<i>60</i>		

RECEIVED


FEB 9 1989

Department of Natural Resources
Bureau of Land & Water Resources

IF MORE SPACE IS NEEDED, USE BACK

If well telescopes please sketch and show depths.

GROUND LEVEL

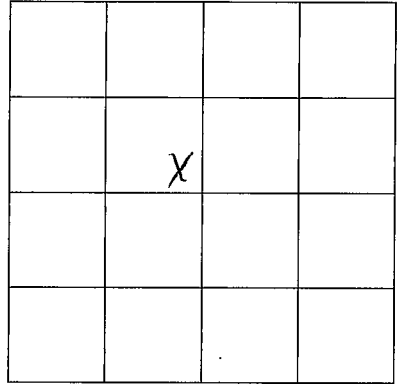

SECTION 16

Please indicate well location X.

ADDITIONAL INFORMATION

If more than one screen,
show location of each on sketch.