

**MISSISSIPPI DEPARTMENT OF ENVIRONMENTAL QUALITY**  
Bureau of Land and Water Resources

P. O. Box 10631  
Jackson, MS 39289-0631  
**WATER WELL DRILLERS LOG**

COUNTY WELL LOCATED:  
Pike

WELL NUMBER: B      CODED

DATE WELL COMPLETED:  
2076  
Apr 6-92

PERMIT NUMBER

NAME OF DRILLING FIRM:  
FITZGERALD Well Serv

NAME & MAILING ADDRESS OF LANDOWNER:  
Chuck Harrell  
RR Summit ms -

WELL LOCATION:    SEC    TOWNSHIP    RANGE  
19    4    N 8 E  
S    8    W

DISTANCE    DIRECTION    NEAREST TOWN  
3 Miles    NE    of Summit

OTHER LANDMARK

WELL PURPOSE: Home, Irrigation, Municipal, Industrial, Fish Pond, etc.  
Home

**PUMP DATA**

PUMP TYPE (Circle One):  
 Submersible,    Turbine,    Jet    Flowing Well,  
Other (Describe) \_\_\_\_\_

POWER TYPE (Circle One):  
 Electric,    Tractor,    Diesel,    Gasoline,    Butane,  
Other (Describe) \_\_\_\_\_    H/P 3/4

Pump Capacity (GPM)	No. of Stages	Setting Depth
<u>10</u>	<u>12</u>	<u>110</u> FT.

PUMP TEST

Well yielded 20 GPM with  
a drawdown of 2 ft.  
after 2 hours of pumping

**WELL DATA**

Well Depth <u>140</u>	Casing Diameter (In.) <u>4</u>	Casing Length (Ft.) <u>130</u>
Type of Casing <u>Pvc</u>	Hole Depth <u>140</u>	Depth to Static Water Level <u>80</u>

TYPE OF COMPLETION: (Circle One or More):  
 Gravel Packed,    Underreamed,    Telescoped,  
 Natural Development,    Open-Hole,    Other \_\_\_\_\_

Top of Lap Pipe or Reduction in Casing

FEET    IF TELESCOPED OR MORE THAN ONE SCREEN: USE BACK PAGE

**LOG DATA**

TYPE OF LOG RUN (Circle One):  
 No Log Run,  
Electric, Gamma Ray, Density, Sonic, Neutron,  
Other (Describe) \_\_\_\_\_

Name of Organization Running Log

**SCREEN DATA**

Diameter - Inches <u>4</u>	Length - Feet <u>10</u>	Slot Size - Inches <u>.014</u>
Screen Type <u>Pvc</u>	Depth to Bottom - Feet <u>140</u>	

**GEOLOGIC DATA (Office Use Only)**

Surface Elev.	Geologic Unit	Unit Thickness	Depth to Top
Subs. SWL	Date	Analysis	Aquifer Test

Driller's Remarks


DESCRIPTION OF FORMATIONS ENCOUNTERED	FROM	TO	FORMATIONS (Continued)	FROM	TO
<u>Red Clay</u>	<u>0</u>	<u>20</u>	<b>RECEIVED</b>  <b>APR 23 1992</b>		
<u>Red Sand</u>	<u>20</u>	<u>125</u>			
<u>Coarse Sand &amp; Gravel</u>	<u>125</u>	<u>140</u>			

Dept. of Environmental Quality  
Bureau of Land & Water Resources

IF MORE SPACE IS NEEDED, USE BACK

If well telescopes please  
sketch and show depths.

GROUND LEVEL

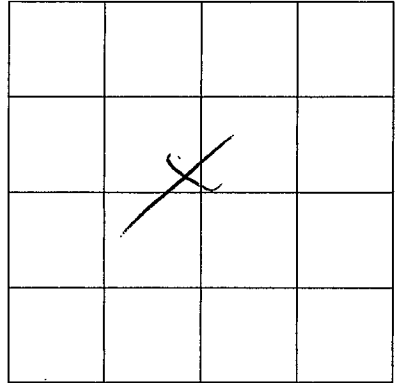

SECTION 19

Please indicate well location X.

ADDITIONAL INFORMATION

If more than one screen,  
show location of each on sketch.