

MISSISSIPPI DEPARTMENT OF ENVIRONMENTAL QUALITY
Bureau of Land and Water Resources

P. O. Box 10631
Jackson, MS 39289-0631
WATER WELL DRILLERS LOG

COUNTY/WELL LOCATED
Pike

WELL NUMBER
B

CODED

DATE WELL COMPLETED
2019
Aug 6-92

PERMIT NUMBER

NAME OF DRILLING FIRM
Fitzgerald Well Serv

NAME & MAILING ADDRESS OF LANDOWNER
CHARLES PARRS
P.O. Summit MS

WELL LOCATION: SEC 4 TOWNSHIP 4 RANGE 8 ^N _S ^E _W

DISTANCE 8 Miles DIRECTION NE of NEAREST TOWN Summit

OTHER LANDMARK

WELL PURPOSE: Home, Irrigation, Municipal, Industrial, Fish Pond, etc.
Home

PUMP DATA

PUMP TYPE (Circle One):
~~Submersible~~ Turbine, Jet, Flowing Well,
Other (Describe) _____

POWER TYPE (Circle One):
~~Electric~~, Tractor, Diesel, Gasoline, ¹/₂ Butane,
Other (Describe) _____ H/P 1/2

Pump Capacity (GPM) 10 No. of Stages 8 Setting Depth 115 FT.

PUMP TEST

Well yielded 20 GPM with
a drawdown of 4 ft.
after 2 hours of pumping

WELL DATA

Well Depth <u>142</u>	Casing Diameter (In.) <u>4</u>	Casing Length (Ft.) <u>132</u>
Type of Casing <u>NOC</u>	Hole Depth <u>142</u>	Depth to Static Water Level <u>82</u>

TYPE OF COMPLETION: (Circle One or More):
 Gravel Packed, Underreamed, Telescoped,
 Natural Development, Open Hole, Other

Top of Lap Pipe or Reduction in Casing

FEET IF TELESCOPED OR MORE THAN ONE SCREEN: USE BACK PAGE

LOG DATA

TYPE OF LOG RUN (Circle One):
Electric, Gamma Ray, Density, Sonic, No Log Run, Neutron,
Other (Describe) _____

Name of Organization Running Log

SCREEN DATA

Diameter - Inches <u>4</u>	Length - Feet <u>10</u>	Slot Size - Inches <u>.014</u>
Screen Type <u>NOC</u>	Depth to Bottom - Feet <u>142</u>	

GEOLOGIC DATA (Office Use Only)

Surface Elev.	Geologic Unit	Unit Thickness	Depth to Top
Subs. SWL	Date	Analysis	Aquifer Test


Driller's Remarks

DESCRIPTION OF FORMATIONS ENCOUNTERED	FROM	TO	FORMATIONS (Continued)	FROM	TO
<i>Red Clay</i>	<i>0</i>	<i>20</i>			
<i>Red Sand</i>	<i>20</i>	<i>90</i>			
<i>Red Soil</i>	<i>90</i>	<i>121</i>			
<i>Red Sand</i>	<i>121</i>	<i>130</i>			
<i>Coarse Sand</i>	<i>130</i>	<i>142</i>			

IF MORE SPACE IS NEEDED, USE BACK

If well telescopes please
sketch and show depths.

GROUND LEVEL

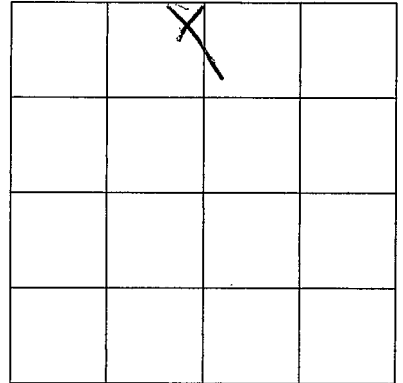

SECTION X

Please indicate well location X.

ADDITIONAL INFORMATION

If more than one screen,
show location of each on sketch.