

MISSISSIPPI DEPARTMENT OF ENVIRONMENTAL QUALITY

Office of Land and Water Resources

P. O. Box 10631
Jackson, MS 39289-0631
WATER WELL DRILLERS LOG

COUNTY WELL LOCATED <i>Dike</i>	
WELL NUMBER <i>B</i>	CODED
DATE WELL COMPLETED <i>2080 Dec 18, 92</i>	

PERMIT NUMBER
NAME OF DRILLING FIRM <i>FITZGEROLD Well Serv</i>

NAME & MAILING ADDRESS OF LANDOWNER <i>Joyce SANDERS</i>			
<i>RR. McComb, MS</i>			
WELL LOCATION:	SEC <i>31</i>	TOWNSHIP <i>4 N</i>	RANGE <i>8 E</i>
DISTANCE <i>1</i> Miles	DIRECTION <i>N</i>	NEAREST TOWN <i>McComb</i>	
OTHER LANDMARK			
WELL PURPOSE: Home, Irrigation, Municipal, Industrial, Fish Pond, etc. <i>Home</i>			

PUMP DATA		
PUMP TYPE (Circle One): <u>Submersible</u> Turbine, Jet, Flowing Well, Other (Describe)		
POWER TYPE (Circle One): <u>Electric</u> , Tractor, Diesel, Gasoline, Butane, Other (Describe) <i>H/P 1/2</i>		
Pump Capacity (GPM) <i>10</i>	No. of Stages <i>8</i>	Setting Depth <i>85</i> FT.
PUMP TEST		
Well yielded <i>20</i> GPM with a drawdown of <i>2</i> ft. after <i>2</i> hours of pumping		

WELL DATA		
Well Depth <i>98</i>	Casing Diameter (In.) <i>4</i>	Casing Length (Ft.) <i>88</i>
Type of Casing <i>PVC</i>	Hole Depth <i>98</i>	Depth to Static Water Level <i>65</i>
TYPE OF COMPLETION: (Circle One or More): <u>Gravel Packed</u> , Underreamed, Telescoped, <u>Natural Development</u> , Open Hole, Other		
WELL GROUTED TO A DEPTH OF <i>60</i> FEET Type Grout (circle one): Cement, Bentonite, or Mix		

LOG DATA	
TYPE OF LOG RUN (Circle One): Electric, Gamma Ray, Density, Sonic, <u>Neutron</u> , Other (Describe)	
Name of Organization Running Log	

SCREEN DATA		
Diameter - Inches <i>4</i>	Length - Feet <i>10</i>	Slot Size - Inches <i>.014</i>
Screen Type <i>PVC</i>	Depth to Bottom - Feet <i>98</i>	

GEOLOGIC DATA (Office Use Only)			
Surface Elev.	Geologic Unit	Unit Thickness	Depth to Top
Subs. SWL	Date	Analysis	Aquifer Test
Driller's Remarks			


DESCRIPTION OF FORMATIONS ENCOUNTERED	FROM	TO
<i>Red Clay</i>	<i>0</i>	<i>20</i>
<i>Red Sand</i>	<i>20</i>	<i>82</i>
<i>Course Sands & gravel</i>	<i>82</i>	<i>98</i>

FORMATIONS (Continued)	FROM	TO
RECEIVED		
<i>JAN 11/1993</i>		
Dept. of Environmental Quality Bureau of Land & Water Resources		

IF MORE SPACE IS NEEDED, USE BACK

If well telescopes please sketch and show depths.

GROUND LEVEL

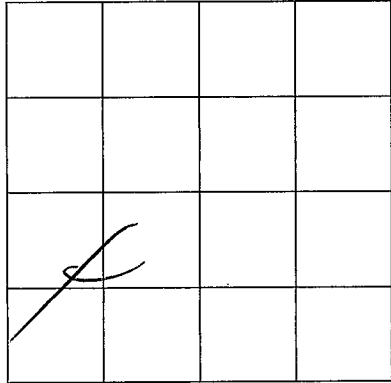

SECTION 31

Please indicate well location X.

ADDITIONAL INFORMATION

If more than one screen,
show location of each on sketch.