

MISSISSIPPI DEPARTMENT OF ENVIRONMENTAL QUALITY

Office of Land and Water Resources

P. O. Box 10631
Jackson, MS 39289-0631

WATER WELL DRILLERS LOG

COUNTY WELL LOCATED <i>Pike</i>	
WELL NUMBER <i>B</i>	CODED
DATE WELL COMPLETED <i>2087</i> <i>Oct 3, 94</i>	

PERMIT NUMBER
NAME OF DRILLING FIRM <i>F. J. GERARD Well Serv</i>

NAME & MAILING ADDRESS OF LANDOWNER <i>LANNELLE WILLIAMS</i> <i>R.R. Summit ms</i>			
WELL LOCATION:	SEC	TOWNSHIP	RANGE
	<i>25</i>	<i>4</i>	<i>N 8 E</i> <i>S 8 W</i>
DISTANCE	DIRECTION	NEAREST TOWN	
<i>6</i> Miles	<i>E</i>	<i>McComb</i>	
OTHER LANDMARK			
WELL PURPOSE: Home, Irrigation, Municipal, Industrial, Fish Pond, etc. <i>Home</i>			

PUMP DATA		
PUMP TYPE (Circle One): <input checked="" type="checkbox"/> Submersible, <input type="checkbox"/> Turbine, <input type="checkbox"/> Jet <input type="checkbox"/> Flowing Well, Other (Describe) _____		
POWER TYPE (Circle One): <input checked="" type="checkbox"/> Electric, <input type="checkbox"/> Tractor, <input type="checkbox"/> Diesel, <input type="checkbox"/> Gasoline, <input type="checkbox"/> Butane, Other (Describe) _____ H/P <i>1/2</i>		
Pump Capacity (GPM) <i>10</i>	No. of Stages <i>8</i>	Setting Depth <i>105</i> FT.
PUMP TEST		
Well yielded <i>20</i> GPM with a drawdown of <i>2</i> ft. after <i>2</i> hours of pumping		

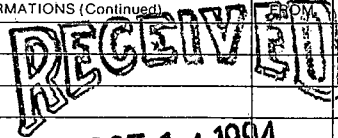
WELL DATA		
Well Depth <i>130</i>	Casing Diameter (In.) <i>4</i>	Casing Length (Ft.) <i>120</i>
Type of Casing <i>PVC</i>	Hole Depth <i>130</i>	Depth to Static Water Level <i>75</i>
TYPE OF COMPLETION: (Circle One or More): <input checked="" type="checkbox"/> Gravel Packed, <input type="checkbox"/> Underreamed, <input type="checkbox"/> Telescoped, <input type="checkbox"/> Natural Development, <input type="checkbox"/> Open Hole, <input type="checkbox"/> Other (Describe) _____		
WELL GROUTED TO A DEPTH OF <i>60</i> FEET Type Grout (circle one): Cement, Bentonite, <input checked="" type="checkbox"/> Mix		

LOG DATA	
TYPE OF LOG RUN (Circle One): <input checked="" type="checkbox"/> No Log Run, <input type="checkbox"/> Electric, <input type="checkbox"/> Gamma Ray, <input type="checkbox"/> Density, <input type="checkbox"/> Sonic, <input type="checkbox"/> Neutron, Other (Describe) _____	
Name of Organization Running Log	

SCREEN DATA		
Diameter - Inches <i>4</i>	Length - Feet <i>10</i>	Slot Size - Inches <i>1012</i>
Screen Type <i>PVC</i>	Depth to Bottom - Feet <i>130</i>	

GEOLOGIC DATA (Office Use Only)			
Surface Elev.	Geologic Unit	Unit Thickness	Depth to Top
Subs. SWL	Date	Analysis	Aquifer Test

Driller's Remarks	
Top of Lap Pipe or Reduction in Casing	
FEET	IF TELESCOPED OR MORE THAN ONE SCREEN: USE BACK PAGE

DESCRIPTION OF FORMATIONS ENCOUNTERED	FROM	TO	FORMATIONS (Continued)	FROM	TO
<i>Red Clay</i>	<i>0</i>	<i>20</i>	 OCT 14 1994 Dept. of Environmental Quality Office of Land & Water Resources		
<i>Red Sand</i>	<i>20</i>	<i>60</i>			
<i>White Chalk</i>	<i>60</i>	<i>116</i>			
<i>Course Sand</i>	<i>116</i>	<i>130</i>			

IF MORE SPACE IS NEEDED, USE BACK

If well telescopes please sketch and show depths.

GROUND LEVEL

			X

SECTION 25

Please indicate well location X.

ADDITIONAL INFORMATION

If more than one screen,
show location of each on sketch.