

MISSISSIPPI DEPARTMENT OF ENVIRONMENTAL QUALITY

Office of Land and Water Resources

P. O. Box 10631
Jackson, MS 39289-0631
WATER WELL DRILLERS LOG

COUNTY WELL LOCATED PIKE	
WELL NUMBER B-2178	CODED
DATE WELL COMPLETED 10-22-99	

PERMIT NUMBER 0-287
NAME OF DRILLING FIRM REEVES WELL SER.

NAME & MAILING ADDRESS OF LANDOWNER OLIVER W. Young		
1103 SCHMIDT RD.		
M & Comb MISS.		
WELL LOCATION: SEC	TOWNSHIP	RANGE
10	4	8
DISTANCE	DIRECTION	NEAREST TOWN
6 Miles	E	SUMMIT
OTHER LANDMARK		
WELL PURPOSE: <u>Home</u> , Irrigation, Municipal, Industrial, Fish Pond, etc.		

PUMP DATA		
PUMP TYPE (Circle One): Submersible, Turbine, Jet, Flowing Well, Other (Describe) _____		
POWER TYPE (Circle One): Electric, Tractor, Diesel, Gasoline, Butane, Other (Describe) _____ H/P 12		
Pump Capacity (GPM) 10	No. of Stages 8	Setting Depth FT.
PUMP TEST		
Well yielded 50 GPM with a drawdown of 0 ft. after 1 hours of pumping		

WELL DATA		
Well Depth 110'	Casing Diameter (In.) 4"	Casing Length (Ft.) 20'
Type of Casing PVC	Hole Depth 110'	Depth to Static Water Level 70'
TYPE OF COMPLETION: (Circle One or More): Gravel Packed, Underreamed, Telescoped, Natural Development, Open Hole, Other (Describe) 10 Gal sand		
WELL GROUTED TO A DEPTH OF 10 FEET Type Grout (circle one): Cement, Bentonite, or Mix		

LOG DATA	
TYPE OF LOG RUN (Circle One): No Log Run, Electric, Gamma Ray, Density, Sonic, Neutron, Other (Describe) _____	
Name of Organization Running Log	

SCREEN DATA		
Diameter - Inches 4"	Length - Feet 10'	Slot Size - Inches 10ths
Screen Type PVC	Depth to Bottom - Feet 110'	

GEOLOGIC DATA (Office Use Only)			
Surface Elev.	Geologic Unit	Unit Thickness	Depth to Top
Subs. SWL	Date	Analysis	Aquifer Test
Driller's Remarks			
Top of Lap Pipe or Reduction in Casing			
FEET			
IF TELESCOPED OR MORE THAN ONE SCREEN: USE BACK PAGE			


DESCRIPTION OF FORMATIONS ENCOUNTERED	FROM	TO	FORMATIONS (Continued)	FROM	TO
Clay	0	20			
sand & gravel	20	70			
Chalk	70	90			
sand & gravel	90	110			

RECEIVED
FEB 27 2002
BY: OLWR

IF MORE SPACE IS NEEDED, USE BACK

If well telescopes please sketch and show depths.

GROUND LEVEL

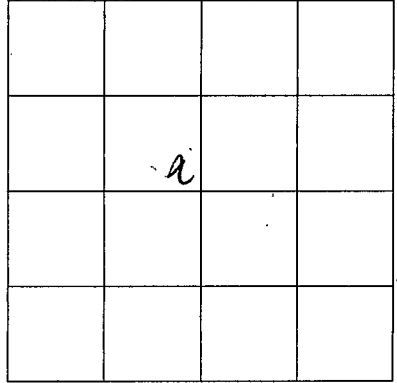

SECTION 10

Please indicate well location X.

ADDITIONAL INFORMATION

If more than one screen,
show location of each on sketch.