

Duplicate

MISSISSIPPI
BOARD OF WATER COMMISSIONERS
416 North State Street
Jackson, Mississippi 39201

WATER WELL DRILLERS LOG

Pike
C
4-22-69

4-22 1969 Fitzgerald well dr Pike
date well completed firm name county well located

LANDOWNER:

Betty Joe Bayal [Home]

(mailing address)

description of formations encountered

from to

<u>Red clay</u>	<u>0</u>	<u>20</u>
<u>Red sand</u>	<u>20</u>	<u>60</u>
<u>White chalk</u>	<u>60</u>	<u>75</u>
<u>Blue "</u>	<u>75</u>	<u>87</u>
<u>White "</u>	<u>87</u>	<u>105</u>
<u>Blue sand</u>	<u>105</u>	<u>117</u>
<u>Coarse sand & gravel</u>	<u>117</u>	<u>132</u>

WELL LOCATION:

sec. 33 T 4 N R 9 E
S W
12 miles E of McComb
(distance) (direction) (nearest town)

WELL PURPOSE:

Home
(home, irrigation, municipal, industrial)

WELL COMPLETION DATA:


- (1) diameter (inches) 4
- (2) total depth (feet) 132
- (3) static water level (feet) 75 below above top of ground.
- (4) casing Plastic, 126
(material) (depth)
4 If telescope see back.
(size)
- (5) screen 6, 126
(length) (depth to top)
4, Plastic
(size) (material)
- (6) pump 1/2, 12
(HP) (yield gpm)
Electric
(type power)
- (7) electric log no
(yes or no)
(organization running log)
- (8) how well bottom plugged good

DRILLERS REMARKS:

APR 28 1969
MISS. BLDG. OF
WATER CONTROL

If well telescopes please sketch and show depths.

GROUND LEVEL

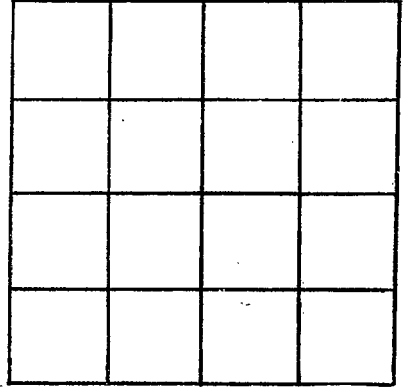

SECTION 23

Please indicate well location X.

ADDITIONAL INFORMATION

If more than one screen,
show locations of each on sketch.