

MISSISSIPPI BOARD OF WATER COMMISSIONERS

PIKE
C3

CODED

WATER WELL DRILLERS LOG

CODED


Date: 9-7-63, 1963, Driller: Chester Reeves County: Pike
(Name)

- (1) Owner of Land: Attorney General
(Name)
RFD 1 Summit
(Address)
- (2) Location: 1/4, 1/4, Sec. 28 T 4 R 9
1 miles west of Pinedale
(distance) (direction) (Nearest Town)
- (3) Topography: Hilly
(Hilly) (Flat) (Level)
- (4) Purpose of Well: Domestic
(Domestic Irrigation
Municipal, Industrial, Other)

Description & Color of Materials Sand, Clay, Red Clay, Shell, etc.	Thick- ness Feet	Dep- th Feet
<u>Red Clay</u>	<u>25</u>	<u>25</u>
<u>hard brown clay (gravel)</u>	<u>90</u>	<u>115</u>

Information upon completion of well:

- (1) Diameter 4 inches.
- (2) Total Depth 115 feet.
- (3) Water Level 99 feet below top of ground.
- (4) Cased to Bottom Size 4"
- (5) Screen: Size 4", Length 5'
- (6) Were any formations sealed against pollution?
_____ yes, no.

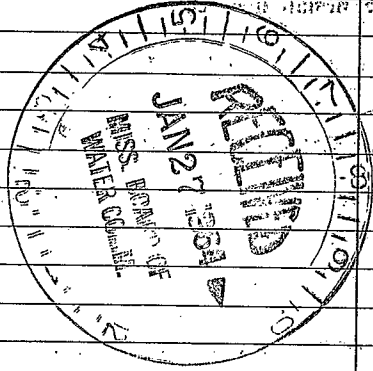

CODED

If YES depth of formation _____
Why _____
Drillers Remarks: New House

REEVES WELL & PUMP CO.
P. O. BOX 71 PHONE 684-1451
McCOMB, MISS.

(Use Back Side)

Well No.

