

PIKE

MISSISSIPPI BOARD OF WATER COMMISSIONERS

C7

4-2-66 CODED

WATER WELL DRILLERS LOG

Date: 4-2, 1966, Driller: F.T. Covington County Pike (Name)

(1) Owner of Land: W.L. Feller (Name)
 Summit, Miss (Address)

(2) Location: 1/4, 1/4, Sec. 16 T14R9,
 12 miles E of Summit (distance) (direction) (Nearest Town)

(3) Topography: Hills (Hilly) Flat (Flat) Level (Level)

(4) Purpose of Well: Domestic (Domestic Irrigation, Municipal, Industrial, Other)

| Description & Color of Materials Sand, Clay, Red Clay, Shell, etc. | Thick- ness Feet | Depth Feet |
|---|------------------------|---------------|
| Sand & gravel | 25 | 25 |
| Rocks and sand | 45 | 70 |
| Sand and Rock | 28 | 98 |

Information upon completion of well:

(1) Diameter 4" inches.

(2) Total Depth 98' feet.


(3) Water Level 70' feet below top of ground.

(4) Cased to 98', Size 4"

(5) Screen: Size 4", Length 6'

(6) Were any formations sealed against pollution?
 yes, no. no.

CODED

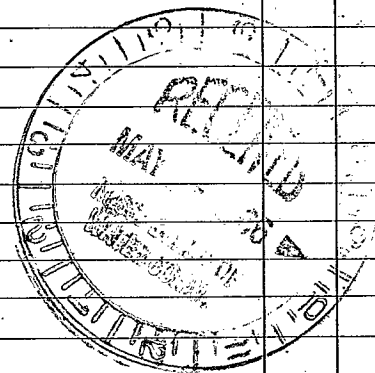

If YES depth of formation _____

Why _____

Drillers Remarks: _____

Well No.

(Use Back Side)

