

**MISSISSIPPI
BOARD OF WATER COMMISSIONERS**
416 North State Street
Jackson, Mississippi 39201

WATER WELL DRILLERS LOG

Pike CODED
C10
7-66

7-16 1966 Fitzgerald National Pike
 date well completed firm name county well located

LANDOWNER: James Patterson
Superior Pt 3 Miss
 (mailing address)

description of formations encountered	from	to
Top soil	0	20
Sand	60	80
Chalk white	35	115
Sand + gravel	15	130

WELL LOCATION:
 sec. 23 T 4 N 9 E
12 miles E-NE of McComb
 (distance) (direction) (nearest town)

WELL PURPOSE: home
 (home, irrigation, municipal, industrial)

- WELL COMPLETION DATA:
- (1) diameter (inches) 4
 - (2) total depth (feet) 126
 - (3) static water level (feet) 90 below above top of ground.
 - (4) casing plastic, 118
 (material) (depth)
 - 4 if telescope see back.
 (size)
 - (5) screen 8, 118
 (length) (depth to top)
 - 4, plastic
 (size) (material)
 - (6) pump Sub 10
 (HP) (yield gpm)
 - Elec
 (type power)
 - (7) electric log No
 (yes or no)

CODED


MISSISSIPPI
 BOARD OF WATER COMMISSIONERS
 JAN 19 1966
 JACKSON, MISSISSIPPI

(organization running log)
 (8) how well bottom plugged Wood
peg

DRILLERS REMARKS:

If well telescopes please sketch and show depths.

GROUND LEVEL

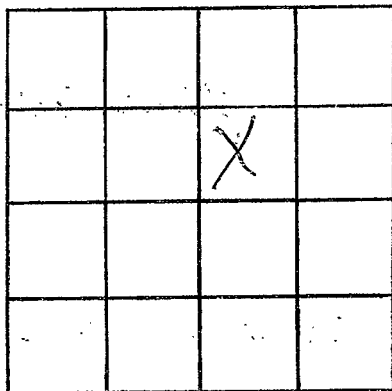

SECTION _____

Please indicate well location X.

ADDITIONAL INFORMATION

If more than one screen,
show locations of each on sketch.