

Pike
C11
10-66

CODED

MISSISSIPPI BOARD OF WATER COMMISSIONERS

CODED WATER WELL DRILLERS LOG

Date: 10-25, 1966 Driller: Vic F. Reynolds County Pike
(When well drilled) (Name) (Where well is located)


1) Owner of Land: Guillermo Boyd
(Name)
Superior Rt 3
(Address)
2) Location: SE 1/4, NE 1/4, Sec 23 T4 R9
4 miles E of Prichard
(distance) (direction) (Nearest Town)
3) Topography: Hilly
(Hilly) (Flat) (Level)
4) Purpose of Well: Domestic
(Domestic Irrigation
Municipal, Industrial, Other)

Description & Color of Materials Sand, Clay, Red Clay, Shell, etc.	Thick- ness Feet	Depth Feet
<u>Top Soil Red Clay</u>	<u>12</u>	<u>12</u>
<u>Red Clay</u>	<u>38</u>	<u>50</u>
<u>Red Chalk</u>	<u>4</u>	<u>54</u>
<u>Dark lignite</u>	<u>28</u>	<u>82</u>
<u>White Chalk</u>	<u>82</u>	<u>82</u>

Information upon completion of well:

1) Diameter 4 inches.
2) Total Depth 82 feet.
3) Water Level 70 feet below top of ground.
4) Cased to 74, Size 4
5) Screen: Size 4", Length 8'
6) Were any formations sealed against pollution?
no

CODED

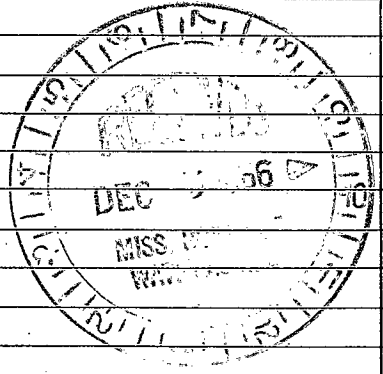

7) YES depth of formation _____
8) Drillers Remarks: _____
9) Yield in gpm: 100 gpm
10) Size pump: Blue
11) Type power: Blue

1870

1871

1872

1873

1874

1875

1876

1877

1878

1879

1880

1881

1882