

CODED

MISSISSIPPI
 BOARD OF WATER COMMISSIONERS
 416 North State Street
 Jackson, Mississippi 39201

WATER WELL DRILLERS LOG

PIKE
~~C 7-67~~ 12
 7-67

7-8 19 69 Fitzgerald Water Well Pike
 date well completed firm name county well located

LANDOWNER: Preston S. Leasing

description of formations encountered	from	to
top soil & clay	0	15
sand	15	48
sand & red gravel	48	65
clay	65	67
white chalk	67	115
sand becoming coarser	115	130

Ruth Rt 1, MISS
 (mailing address)


WELL LOCATION:
 sec 7 T 0 N 11 R 0 E
15 4 S 19 W
15 miles NE of McComb
 (distance) (direction) (nearest town)

WELL PURPOSE: house
 (home, irrigation, municipal, industrial)

WELL COMPLETION DATA:

- (1) diameter (inches) 4
- (2) total depth (feet) 130
- (3) static water level (feet) 80 below top of ground
- (4) casing plastic 124
 (material) (depth)
4 if telescope see back.
 (size)
- (5) screen 61 124
 (length) (depth to top)
4 plastic
 (size) (material)
- (6) pump — —
 (HP) (yield gpm)
—
 (type power)
- (7) electric log no
 (yes or no)
—
 (organization running log)
- (8) how well bottom plugged wood peg


CODED

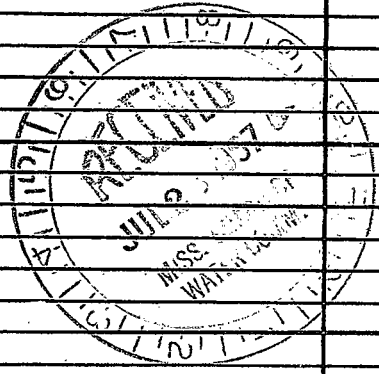

DRILLERS REMARKS:

If well telescopes please sketch and show depths.

GROUND LEVEL

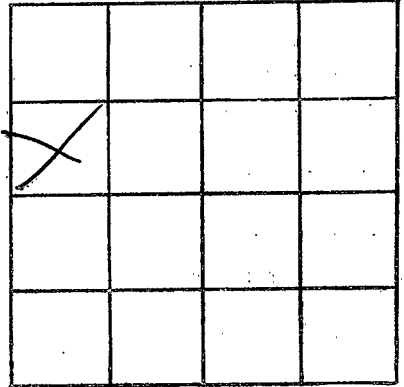

SECTION 1

Please indicate well location X.

ADDITIONAL INFORMATION

If more than one screen, show locations of each on sketch.