

Pike CODED

CB

11-66

MISSISSIPPI BOARD OF WATER COMMISSIONERS

WATER WELL DRILLERS LOG

Date: Nov 14, 1966, Driller: Thos Fitzgerald County Pike
(When well drilled) (Name) (Where well is located)

1) Owner of Land: Mrs. Ophie Price
(Name)
Pricedale, Miss
(Address)

2) Location: NE 1/4, NE 1/4, Sec. 28 T7R9
0 miles IN of Pricedale
(distance) (direction) (Nearest Town)

3) Topography: X
(Hilly) (Flat) (Level)

4) Purpose of Well: Domestic
(Domestic Irrigation
Municipal, Industrial, Other)

Description & Color of Materials Sand, Clay, Red Clay, Shell, etc.	Thick- ness Feet	Depth Feet
		0
<u>Red clay</u>	<u>20</u>	<u>20</u>
<u>fine sand + gravel</u>	<u>25</u>	<u>45</u>
<u>Coarse gravel</u>	<u>10</u>	<u>55</u>

Information upon completion of well:

1) Diameter 4 inches.

2) Total Depth 55 feet.

3) Water Level 30 feet below top of ground.

4) Cased to 47, Size 4"

5) Screen: Size 4", Length 8'

6) Were any formations sealed against pollution?
yes, X no.

CODED

YES depth of formation _____


ny _____

Drillers Remarks: _____

Yield in gpm: 35 gpm

Size pump: A

Type power: _____

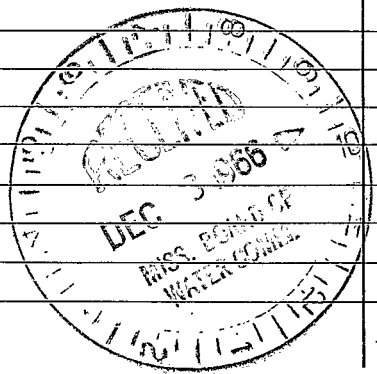

Send this copy to Board of Water Commissioners 429 Miss. St. Jackson, Miss.

