

DIKE CODED
 C14
 7-67

MISSISSIPPI
 BOARD OF WATER COMMISSIONERS
 416 North State Street
 Jackson, Mississippi 39201

WATER WELL DRILLERS LOG

7-14 1967 1967 Fitzgerald Water Well pike
 date well completed firm name county well located

LANDOWNER Jett Myers
Jaynes R. H. Myers
 (mailing address)

description of formations encountered	from	to
top soil & clay	0	20
red sand	20	24
sand & gravel	24	85
sandy sand	85	148
hard & gravel	148	172

WELL LOCATION:
 sec 10 T 4 N 9 R 4 E
10 miles 5 of Roth
 (distance) (direction) (nearest town)

WELL PURPOSE: home
 (home, irrigation, municipal, industrial)

- WELL COMPLETION DATA:
- (1) diameter (inches) 4
 - (2) total depth (feet) 172
 - (3) static water level (feet) 125 below top of ground.
 - (4) casing plastic 1 1/2
 (material) (depth)
4 if telescope see back.
 (size)
 - (5) screen 6' 119
 (length) (depth to top)
4 plastic
 (size) (material)
 - (6) pump 1 1/2 4
 (HP) (yield/gpm)
Spec
 (type power)
 - (7) electric log NO
 (yes or no)
 - (organization running log)
 - (8) how well bottom plugged plugged


CODED



DRILLERS REMARKS:

If well telescopes please sketch and show depths.

GROUND LEVEL

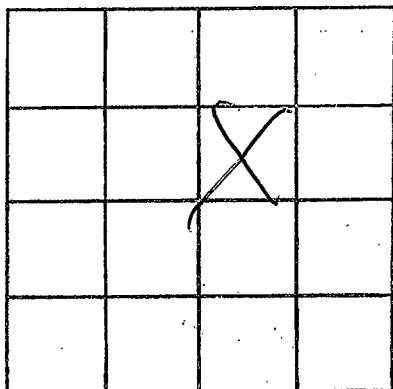

SECTION 10

Please indicate well location X.

ADDITIONAL INFORMATION

If more than one screen, show locations of each on sketch.