

PIKE CODED
 C15
 7-67

MISSISSIPPI
 BOARD OF WATER COMMISSIONERS
 416 North State Street
 Jackson, Mississippi 39201

WATER WELL DRILLERS LOG

7-10 1967 *RK Jones & Sons* Pike
 date well completed firm name county well located

LANDOWNER: Paul McElough
~~RK Jones & Sons~~
RK Jones & Sons
 (mailing address)


description of formations encountered	from	to
top soil & clay	0	10
Red Sand	10	34
bank	34	35
Heavy gravel	35	70
Chalk	70	82
gravel Shale Sand	82	98

WELL LOCATION:
 sec. 15 T4 N 9 E
 S W
12 miles ENE of McComb
 (distance) (direction) (nearest town)

WELL PURPOSE: household
 (home, irrigation, municipal, industrial)

- WELL COMPLETION DATA:
- (1) diameter (inches) 4
 - (2) total depth (feet) 98
 - (3) static water level (feet) 65 ^{below} above top of ground.
 - (4) casing plastic gr
 (material) (depth)
4 if telescope see back.
 (size)
 - (5) screen 6' gr
 (length) (depth to top)
4 (size) plastic (material)
 - (6) pump 1/2 sub 12
 (HP) (yield gpm)
elec (type power)
 - (7) electric log no
 (yes or no)
 (organization running log)
 - (8) how well bottom plugged good peg


CODED

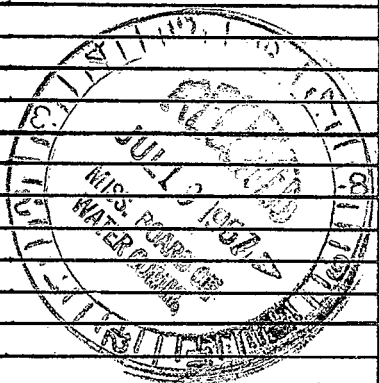

DRILLERS REMARKS:

If well telescopes please sketch and show depths.

GROUND LEVEL

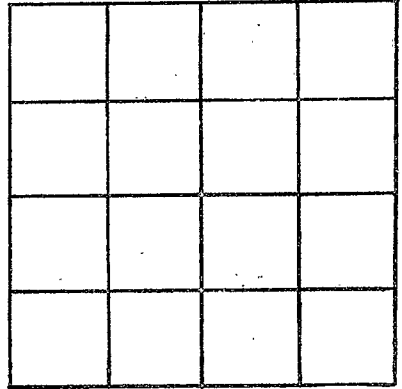

SECTION 15

Please indicate well location X.

ADDITIONAL INFORMATION

If more than one screen,
show locations of each on sketch.