

PIKE CODED
 CH
 7-67

MISSISSIPPI
 BOARD OF WATER COMMISSIONERS
 416 North State Street
 Jackson, Mississippi 39201

WATER WELL DRILLERS LOG

7-15 1967 Fitzgerald Water Well Ditke
 date well completed firm name county well located

LANDOWNER: Mysis O'Grain

description of formations encountered from to

Summit #1
 (mailing address)

Top soil / Clay	0	20
Sand	20	35
Sand & Heavy gravel	35	78
White Chalk	78	100
Fine sand	100	140
Peppered (Chance Sup)	100	160


WELL LOCATION:
 sec 22 T. 4 N. R. 9 E. S. 1 W.
12 miles E of M'Comb
 (distance) (direction) (nearest town)

WELL PURPOSE: home
 (home, irrigation, municipal, industrial)

WELL COMPLETION DATA:

- (1) diameter (inches) 4
- (2) total depth (feet) 160
- (3) static water level (feet) 125 below above top of ground.
- (4) casing plastic 157
 (material) (depth)
4 if telescope see back.
 (size)
- (5) screen 6' 157
 (length) (depth to top)
4 plastic
 (size) (material)
- (6) pump 1/2 Sub 109 gpm
 (HP) (yield gpm)
Steel
 (type power)
- (7) electric log No
 (yes or no)
 (organization running log)
- (8) how well bottom plugged Wood peg


CODED

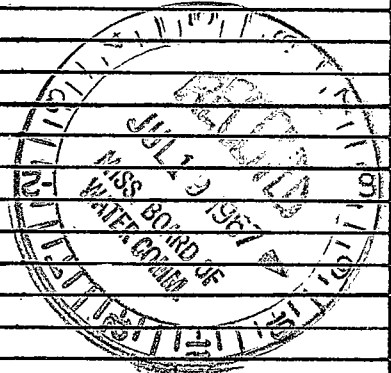

DRILLERS REMARKS:

If well telescopes please sketch and show depths.

GROUND LEVEL

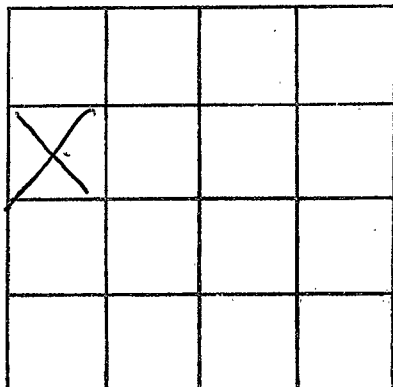

SECTION *12*

Please indicate well location X.

ADDITIONAL INFORMATION

If more than one screen, show locations of each on sketch.