

**MISSISSIPPI  
BOARD OF WATER COMMISSIONERS**  
416 North State Street  
Jackson, Mississippi 39201

**WATER WELL DRILLERS LOG**

Pike
C17 CODED
7-67

July 20 1967 *Keenes Well Drillers* *Pike*  
 date well completed, firm name, county well located

LANDOWNER: *Boyd Keenes*  
*R.F.D.*  
*Jayless -*  
 (mailing address)

WELL LOCATION:  
 sec. 22 T. 4 N. R. 9 E  
 1 miles *N. N. E. Pinedale*  
 (distance) (direction) (nearest town)

WELL PURPOSE: *Home*  
 (home, irrigation, municipal, industrial)

WELL COMPLETION DATA:

(1) diameter (inches) *4"*  
 (2) total depth (feet) *182'*  
 (3) static water level (feet) *105'* below top of ground.  
 (4) casing *Plastic Bottom*  
 (material) (depth)  
 \_\_\_\_\_ if telescope see back.  
 (size)  
 (5) screen *6" 176'*  
 (length) (depth to top)  
*1 1/2" Plastic*  
 (size) (material)  
 (6) pump *3/4" sub 12"*  
 (HP) (yield gpm)  
*Electric*  
 (type power)  
 (7) electric log *No -*  
 (yes or no)  
 \_\_\_\_\_  
 (organization running log)

description of formations encountered	from	to
<i>Red clay &amp; gravel</i>	<i>0</i>	<i>17</i>
<i>Red sand</i>	<i>17</i>	<i>60</i>
<i>sand &amp; gravel</i>	<i>60</i>	<i>95</i>
<i>mixed sand &amp; gravel &amp; chert</i>	<i>95</i>	<i>170</i>
<i>Red gravel &amp; sand</i>	<i>170</i>	<i>182</i>


CODED

DRILLERS REMARKS:  
*old well bad*



If well telescopes please sketch and show depths.

GROUND LEVEL

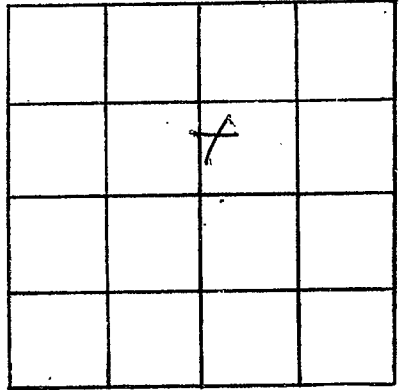

SECTION 27

Please indicate well location X.

ADDITIONAL INFORMATION

If more than one screen,  
show locations of each on sketch.