

DIKE  
C18  
7-67

CODED

MISSISSIPPI  
BOARD OF WATER COMMISSIONERS  
416 North State Street  
Jackson, Mississippi 39201

WATER WELL DRILLERS LOG

7-20 date well completed  
 Ed Fitzgerald firm name  
 pike county well located

LANDOWNER: Fred Falter

description of formations encountered

RT-1 Summit Moss  
 (mailing address)

| description of formations encountered | from | to |
|---------------------------------------|------|----|
| topsoil & sand                        | 0    | 20 |
| sand & gravel                         | 20   | 30 |
| chalk                                 | 30   | 37 |
| shale & gravel                        | 37   | 60 |

WELL LOCATION:


31 T 4 N R 9 E  
 S W  
 7 miles E of Melrose  
 (distance) (direction) (nearest town)

WELL PURPOSE: home  
 (home, irrigation, municipal, industrial)

WELL COMPLETION DATA:

- (1) diameter (inches) 4/60
- (2) total depth (feet) 60
- (3) static water level (feet) 20 below top of ground.
- (4) casing plastic 54 (material) (depth)
- 4 If telescope see back. (size)
- (5) screen 6' 54 (length) (depth to top)
- 4 plastic (size) (material)
- (6) pump 1/2 HP 10 GPM (HP) (yield gpm)
- 5 hp (type power)
- (7) electric log No (yes or no)
- (organization running log)
- (8) how well bottom plugged Wood peg


CODED

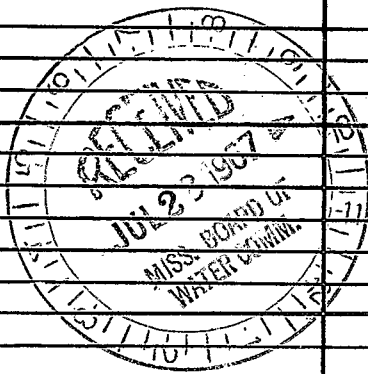

DRILLERS REMARKS:

If well telescopes please sketch and show depths.

GROUND LEVEL

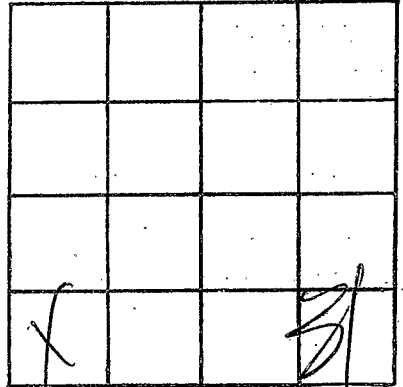

SECTION \_\_\_\_\_

Please indicate well location X.

ADDITIONAL INFORMATION

If more than one screen,  
show locations of each on sketch.