

**MISSISSIPPI
BOARD OF WATER COMMISSIONERS**
416 North State Street
Jackson, Mississippi 39201

WATER WELL DRILLERS LOG

PIKE
CODED CH
8-67

8-18-1967 Fitzgerald W. Jones Pike
 date well completed firm name county well located

LANDOWNER: E. Dillon
R. Tyler town
 (mailing address)


description of formations encountered	from	to
Top soil & clay	0	20
Sand	20	105
Sand & gravel	105	160
Chalk	160	

WELL LOCATION:
 sec. 32 T 4 N R 9 E
8 miles E of McComb
 (distance) (direction) (nearest town)

WELL PURPOSE: home
 (home, irrigation, municipal, industrial)

- WELL COMPLETION DATA:
- diameter (inches) 4
 - total depth (feet) 160
 - static water level (feet) 110 below top of ground.
 - casing plastic, 157
 (material) (depth)
4 if telescope see back.
 (size)
 - screen 8" 157
 (length) (depth to top)
4 plastic
 (size) (material)
 - pump 1/2 10
 (HP) (yield gpm)
110e
 (type power)
 - electric log AV
 (yes or no)
 - (organization running log)
 - how well bottom plugged Good Plug


CODED

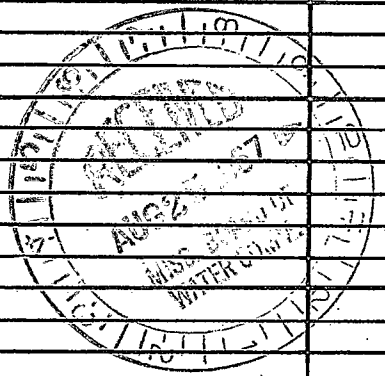

DRILLERS REMARKS:

If well telescopes please sketch and show depths.

GROUND LEVEL

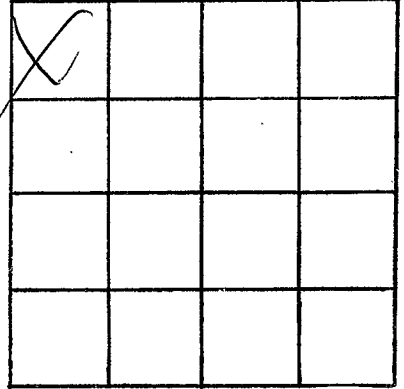

SECTION 39

Please indicate well location X.

ADDITIONAL INFORMATION

If more than one screen, show locations of each on sketch.