

MISSISSIPPI  
BOARD OF WATER COMMISSIONERS  
416 North State Street  
Jackson, Mississippi 39201

WATER WELL DRILLERS LOG

*Pike* CODED  
C20  
12-67

12-13-1967 *19 Fitzgerald Water Well* *Pike*  
date well completed firm name county well located

LANDOWNER: *Pete Dickerson*

description of formations encountered	from	to
<i>top soil &amp; clay</i>	<i>0</i>	<i>20</i>
<i>red sand</i>	<i>20</i>	<i>45</i>
<i>gravel &amp; sand</i>	<i>45</i>	<i>90</i>
<i>chalk</i>	<i>90</i>	<i>102</i>
<i>sand &amp; gravel</i>	<i>102</i>	<i>118</i>

*Highway 118*  
*McComb Miss RT.*  
(mailing address)

WELL LOCATION:

sec *23* T *4* N R *9* E  
*14* miles *E* of *McComb*  
(distance) (direction) (nearest town)

WELL PURPOSE: *home*  
(home, irrigation, municipal, industrial)


WELL COMPLETION DATA:

- (1) diameter (inches) *4/18*
- (2) total depth (feet) *118*
- (3) static water level (feet) *100* below/above top of ground.
- (4) casing *plastic, 112* (material) (depth)  
*4 1/2* (size) if telescope see back.
- (5) screen *6", 112* (length) (depth to top)  
*4", 50 lb 40* (size) (material)
- (6) pump *1/2 sub, 12* (HP) (yield gpm)  
*3 hp* (type power)
- (7) electric log *no* (yes or no)

(organization running log)


(8) how well bottom plugged *wood peg*

DRILLERS REMARKS:

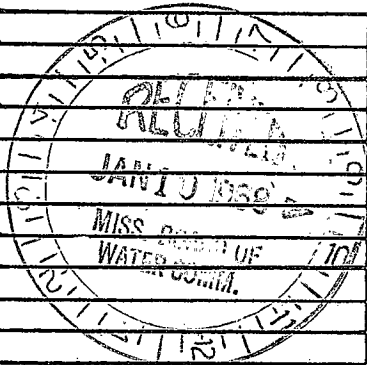

If well telescopes please sketch and show depths.

GROUND LEVEL

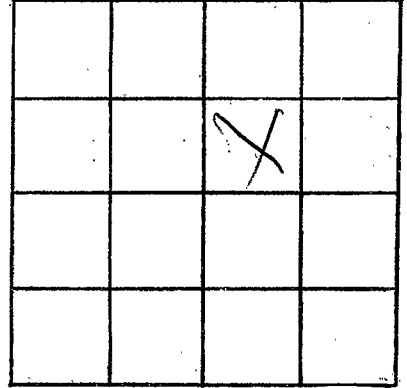

SECTION 23

Please indicate well location X.

ADDITIONAL INFORMATION

If more than one screen, show locations of each on sketch.