

**MISSISSIPPI
BOARD OF WATER COMMISSIONERS**
416 North State Street
Jackson, Mississippi 39201

WATER WELL DRILLERS LOG

Pike
C21 CODED
12-67

12-13 1967 *Litzgerald Water Well pike*
date well completed firm name county well located

LANDOWNER: *Leon Dunaway*
Ruth RA MISS

(mailing address)

WELL LOCATION:
sec. 7 T 4 N 9 R 9 E
S W
5 miles SW of Ruth
(distance) (direction) (nearest town)


WELL PURPOSE: *home*
(home, irrigation, municipal, industrial)

WELL COMPLETION DATA:

- (1) diameter (inches) 4
- (2) total depth (feet) 90
- (3) static water level (feet) 25 below top of ground.
- (4) casing plastic 84
(material) (depth)
4" if telescope see back.
(size)
- (5) screen 6' 84
(length) (depth to top)
4 Seb 40
(size) (material)
- (6) pump — —
(HP) (yield gpm)
elec
(type power)
- (7) electric log no
(yes or no)
—
(organization running log)
- (8) how well bottom plugged Wood peg

description of formations encountered	from	to
<i>topsoil & clay</i>	<i>0</i>	<i>12</i>
<i>red gravel</i>	<i>12</i>	<i>40</i>
<i>Chalk</i>	<i>40</i>	<i>60</i>
<i>Sand & gravel</i>	<i>60</i>	<i>90</i>
<i>Chalk</i>	<i>90</i>	<i>—</i>

CODED

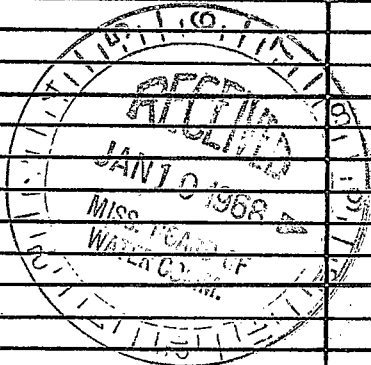

DRILLERS REMARKS: _____

If well telescopes please sketch and show depths.

GROUND LEVEL

X			

SECTION 7

Please indicate well location X.

ADDITIONAL INFORMATION

If more than one screen, show locations of each on sketch.