

Pike

C22

CODED

1-68

MISSISSIPPI  
 BOARD OF WATER COMMISSIONERS  
 416 North State Street  
 Jackson, Mississippi 39201

WATER WELL DRILLERS LOG

Jan 11 1968  
date well completed

Perkins well pumps  
firm name

Pike  
county well located

LANDOWNER: Taylor  
 Young J  
 RFD #1  
 (mailing address)

description of formations encountered

from to

WELL LOCATION:  
 sec. 15 T 4 N R 9 E  
 3 miles (distance) NNE (direction) Kirehad (nearest town)

Red sandy clay	0	15
Bank Shales	15	40
Small gravel & sand	40	45
cherty gravel	45	80
Coarse sand	80	90
Pea gravel & sand	90	98

WELL PURPOSE: Home (home, irrigation, municipal, industrial)

WELL COMPLETION DATA:


- (1) diameter (inches) 4 1/8
- (2) total depth (feet) 98
- (3) static water level (feet) 50 below top of ground.
- (4) casing Plastic bottom (material) (depth)
- (size) if telescope see back.
- (5) screen 4' 92' (length) (depth to top)  
Plastic (material)
- (6) pump 1/2 HP (type power)
- (7) electric log No (yes or no)

CODED

(organization running log)


(8) how well bottom plugged wooden plug

DRILLERS REMARKS:  
odd well  
bad

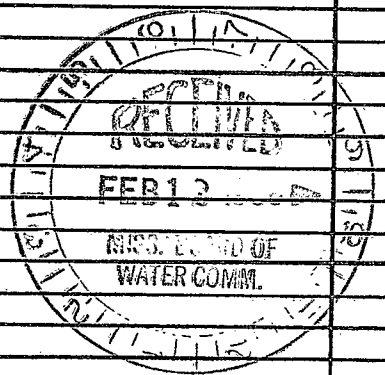

If well telescopes please sketch and show depths.

GROUND LEVEL

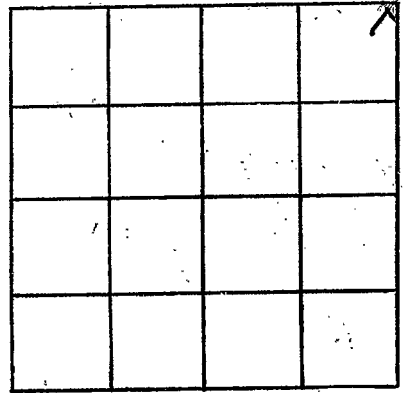

SECTION 15

Please indicate well location X.

ADDITIONAL INFORMATION

If more than one screen,  
show locations of each on sketch.