

PIKE

MISSISSIPPI BOARD OF WATER COMMISSIONERS

C 23 CODED

10-4-63

WATER WELL DRILLERS LOG

CODED

Date: 10-4, 1963, Driller: Chester Reaves County Pike

(Name)

(1) Owner of Land: M. J. Duncan
R. P. Ruth
(Name)
(Address)

Description & Color of Materials
(Sand, Clay, Red Clay, Shell, etc.)
Red yellow
Clay 12-17

Thick-
ness
Feet

(2) Location: 1/4, 1/4, Sec. 8, 7, 9
5 miles N.W. of Pinedale
(distance) (direction) (Nearest Town)

Sand & gravel 18-30
Dark chert
& gravel 30-60

(3) Topography: Hilly
(Hilly) (Flat) (Level)

(4) Purpose of Well: Domestic
(Domestic Irrigation
Municipal, Industrial, Other)

Coarse sand
small pea
gravel 12-72

Information upon completion of well:

(1) Diameter 4 inches.

(2) Total Depth 72 feet.

(3) Water Level 27 feet below top of ground.

(4) Cased to Bottom, Size 4


(5) Screen: Size 4", Length 5'

(6) Were any formations sealed against pollution?
yes, no.

If YES depth of formation

Why

Drillers Remarks: old well
Bad

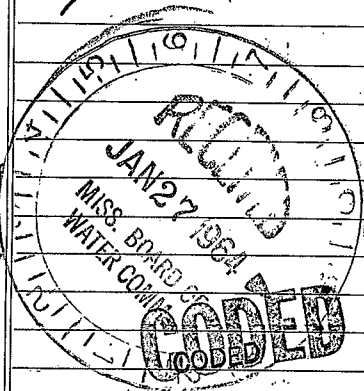

REEVES WELL & PUMP CO.
P. O. BOX 71 -- PHONE 684-451
McCOMB, MISS.

(Use Back Side)

Well No.

