

MISSISSIPPI
BOARD OF WATER COMMISSIONERS
416 North State Street
Jackson, Mississippi 39201

CODED

WATER WELL DRILLERS LOG

PIKE
C25
4-26-71

4-26 date well completed 19 71 firm name *Etzgen & Well* county well located *Pike*

LANDOWNER:	description of formations encountered	from	to
<i>Leon Abraham</i>			
<i>R.H. Jayes, Jr.</i> (mailing address)	<i>Red Clay</i>	<i>0</i>	<i>20</i>
	<i>Red sand</i>	<i>20</i>	<i>70</i>
	<i>Coarse sandstone</i>	<i>70</i>	<i>80</i>
WELL LOCATION:			
sec <i>27</i> T <i>4N</i> R <i>9E</i>			
<i>1/2</i> miles <i>S</i> of <i>Prichard</i>			
(distance) (direction) (nearest town)			
WELL PURPOSE:			
(home, irrigation, municipal, industrial)			
WELL COMPLETION DATA:			
(1) diameter (inches) <i>4</i>			
(2) total depth (feet) <i>80</i>			
(3) static water level (feet) <i>30</i> below above top of ground.			
(4) casing <i>plastic</i> , <i>74</i> (material) (depth)			
<i>4</i> if telescope see back. (size)			
(5) screen <i>6</i> , <i>74</i> (length) (depth to top)			
<i>4</i> (size) <i>plastic</i> (material)			
(6) pump <i>1/2</i> , <i>7</i> (HP) (yield gpm)			
<i>electric</i> (type power)			
(7) electric log <i>yes</i> (yes or no)			
(organization running log)			
(8) how well bottom plugged <i>completely</i>			
DRILLERS REMARKS:			


CODED

MAY 10 1971

MISS. Bd. of
WATER COMMISSIONERS

If well telescopes please
sketch and show depths.

GROUND LEVEL

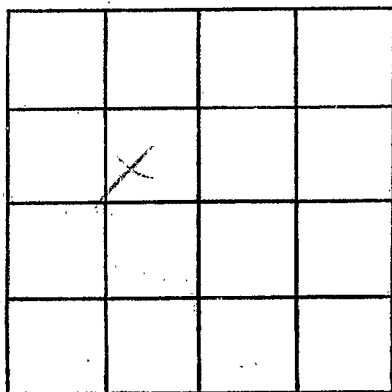

SECTION 27

Please indicate well location X.

ADDITIONAL INFORMATION

If more than one screen,
show locations of each on sketch.