

WATER WELL DRILLERS LOG

Date: 4-3, 1961, Driller: Chester Reeves County: Pike

(Name)

(1) Owner of Land: Chester Pittman
 (Name)
RFD 1, Summit, F.
 (Address)

(2) Location: 1/4, 1/4, Sec. 16 3 R15
10 miles east, of McComb
 (distance) (direction) (Nearest Town)

(3) Topography: Hilly
 (Hilly) (Flat) (Level)

(4) Purpose of Well: Domestic
 (Domestic Irrigation
 Municipal, Industrial, Other)

Description & Color of Materials Sand, Clay, Red Clay, Shell, etc.	Thick- ness Feet	Depth Feet
<u>Red clay</u>	<u>20</u>	<u>20</u>
<u>Red sand</u>	<u>40</u>	<u>60</u>
<u>Small gravel</u>		
<u>Red sand</u>	<u>25</u>	<u>85</u>
<u>gray chalk</u>	<u>35</u>	<u>120</u>
<u>Fine white sand</u>	<u>40</u>	<u>160</u>
<u>Small gravel</u>	<u>6</u>	<u>166</u>

*Current location
12/13/68 JWR*

Information upon completion of well:

(1) Diameter 2 inches.

(2) Total Depth 166 feet.

(3) Water Level 85 feet below top of ground.

(4) Cased to 161, Size 2"


(5) Screen: Size 1 1/4, Length 6'

(6) Were any formations sealed against pollution?
 _____ yes, no.

If YES depth of formation _____

Why _____

Drillers Remarks: Had new well
new house -

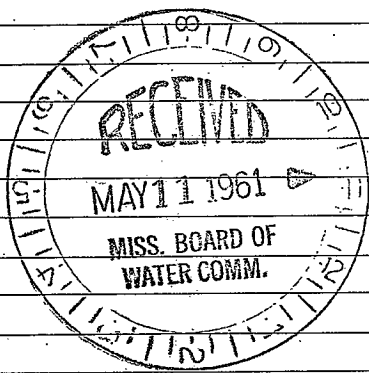

REEVES WELL AND PUMP CO.
 Phone 1250
 McCOMB, MISSISSIPPI

(Use Back Side)

Well No.

