

CODED

MISSISSIPPI
BOARD OF WATER COMMISSIONERS
416 North State Street
Jackson, Mississippi 39201

WATER WELL DRILLERS LOG

PIKE
CODED
C29
9-5-68

Sept 5 1968 O.T. Cournotas Pike
 date well completed firm name county well located

LANDOWNER: Tommy Myers

description of formations encountered	from	to
<u>Sand & Gravel</u>	<u>0</u>	<u>38</u>

(mailing address)

WELL LOCATION:

sec. 18 T. 4 N R. 9 E
11.20 miles East of McCumb
 (distance) (direction) (nearest town)


WELL PURPOSE: Home
 (home, irrigation, municipal, industrial)

WELL COMPLETION DATA:

- (1) diameter (inches) 4"
- (2) total depth (feet) 68'
- (3) static water level (feet) 30' below above top of ground.
- (4) casing Plastic 68'
 (material) (depth)
 (size) if telescope see back.
- (5) screen 6' 62'
 (length) (depth to top)
4" Plastic
 (size) (material)
- (6) pump 2 9
 (HP) (yield gpm)
A.C.
 (type power)
- (7) electric log _____
 (yes or no)

 (organization running log)
- (8) how well bottom plugged wood

DRILLERS REMARKS:

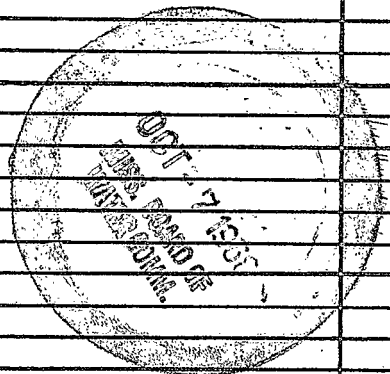

If well telescopes please sketch and show depths.

GROUND LEVEL



SECTION 18

Please indicate well location X.

ADDITIONAL INFORMATION

If more than one screen, show locations of each on sketch.