

PIKE
 C 30
 2-15-69

MISSISSIPPI
 BOARD OF WATER COMMISSIONERS
 416 North State Street
 Jackson, Mississippi 39201

WATER WELL DRILLERS LOG

Feb. 15, 1969 J.T. Conington & Son P. COOPER
 date well completed firm name county well located

LANDOWNER: Smith Building Const
 Price Dale, Miss
 (mailing address)

description of formations encountered	from	to
clay	0	30
sand	30	50
chalk	50	80
sand	80	102

WELL LOCATION:
 sec 35 T 4 N R 9 E
 S S
 3/4 miles South of Price Dale
 (distance) (direction) (nearest town)

WELL PURPOSE: Home
 (home, irrigation, municipal, industrial)


- WELL COMPLETION DATA:
- (1) diameter (inches) 4"
 - (2) total depth (feet) 102'
 - (3) static water level (feet) 81' below top of ground.
 - (4) casing Plastic 96' (material) (depth)
 - (size) If telescope see back.
 - (5) screen 6' 102' (length) (depth to top)
 - 4" Plastic (size) (material)
 - (6) pump 5 (HP) (yield gpm)
 - AICI (type power)
 - (7) electric log (yes or no)
 - (organization running log)
 - (8) how well bottom plugged wood

DRILLERS REMARKS:

COOPER
 MAR 20 1969
 MISS. REG. OF
 WATER

If well telescopes please sketch and show depths.

GROUND LEVEL

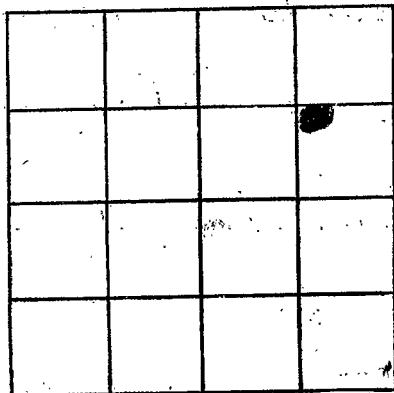

SECTION 2

Please indicate well location X.

ADDITIONAL INFORMATION

If more than one screen, show locations of each on sketch.