

Pike  
 C 31  
 4-8-69

MISSISSIPPI  
 BOARD OF WATER COMMISSIONERS  
 416 North State Street  
 Jackson, Mississippi 39201

CODED  
 CODED

WATER WELL DRILLERS LOG

4-8 1969 date well completed  
 Fitzgould well Inc firm name  
 Pike county well located

LANDOWNER:

Heiman Rice  
 RR. McComb, Miss.  
 (mailing address)

description of formations encountered

from to

Red clay 0 20  
 Red Sand 20 40  
 Coarse Sand & gravel 40 97

WELL LOCATION:

sec 21 T 4 N R 9 E  
 S W  
 9 miles E of McComb  
 (distance) (direction) (nearest town)

WELL PURPOSE: Home  
 (home, irrigation, municipal, industrial)

WELL COMPLETION DATA:

- (1) diameter (inches) 100 4"
- (2) total depth (feet) 100
- (3) static water level (feet) 45 below top of ground.
- (4) casing Plastic, 94 (material) (depth)  
 4 (size) if telescope see back.
- (5) screen 6, 94 (length) (depth to top)  
 4, Plastic (size) (material)
- (6) pump 1/2, 12 (HP) (yield gpm)  
 Elec (type power)
- (7) electric log no (yes or no)  
 (organization running log)
- (8) how well bottom plugged wood plug

EXHAUST


APR 28 1969

DRILLERS REMARKS:

APPROVED BY  
 MISSISSIPPI BOARD OF WATER COMMISSIONERS

If well telescopes please sketch and show depths.

GROUND LEVEL

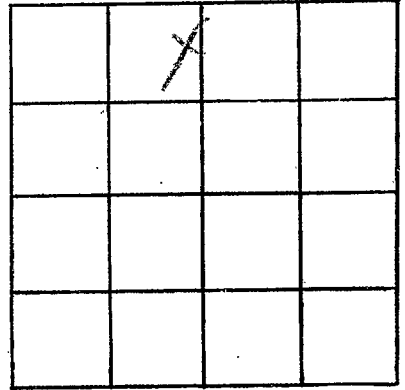

SECTION 21

Please indicate well location X.

ADDITIONAL INFORMATION

If more than one screen,  
show locations of each on sketch.