

Pike
C32
4-22-69

MISSISSIPPI
BOARD OF WATER COMMISSIONERS
416 North State Street
Jackson, Mississippi 39201

CODED
APR 30 1969

WATER WELL DRILLERS LOG

4-22-69 date well completed
Fitzgerald well log firm name
Pike county well located

LANDOWNER:

Billy Joe Bayal [Home]
P.O. Bill Bayal
(mailing address)

description of formations encountered

from to

Red clay	0	20
Red sand	20	60
White chalk	60	75
Blue chalk	75	87
White chalk	87	105
Fine sand	105	117
Coarse sand & gravel	117	132

WELL LOCATION:

sec. 23 T. 4 N. R. 9 E
12 miles E of N'Comb
(distance) (direction) (nearest town)

WELL PURPOSE:

Home
(home, irrigation, municipal, industrial)

WELL COMPLETION DATA:

- (1) diameter (inches) 4
- (2) total depth (feet) 132
- (3) static water level (feet) 75 below top of ground.
- (4) casing Plastic, 126, (material) (depth)
4 (size) if telescope see back.
- (5) screen 6' 126 (length) (depth to top)
4 Plastic (size) (material)
- (6) pump 1/2 12 (HP) (yield gpm)
Elec (type power)
- (7) electric log No (yes or no)
(organization running log)
- (8) how well bottom plugged covered peg


DRILLERS REMARKS:

APR 30 1969

MISS. BD. OF
WATER COM.

If well telescopes please sketch and show depths.

GROUND LEVEL

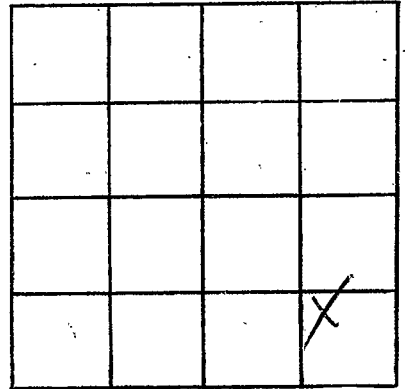

SECTION 23

Please indicate well location X.

ADDITIONAL INFORMATION



If more than one screen, show locations of each on sketch.