

Pike Co
 C 33
 2-16-70

MISSISSIPPI
 BOARD OF WATER COMMISSIONERS
 416 North State Street
 Jackson, Mississippi 39201

CODED

WATER WELL DRILLERS LOG

16 Feb 1970 A.T. Crumpton Pike
 date well completed firm name county well located

LANDOWNER:
 Dudley McCallough
 Ruth, Miss.
 (mailing address)

WELL LOCATION:
 sec. 5 T 4 N R 9 E
 4 miles ~~North~~ East of Ruth
 (distance) (direction) (nearest town)

description of formations encountered	from	to
Clay	0	15
Clay/Gnd	15	35
Gnd/Clay	35	50
Gnd	50	65
Gnd/Gravel	65	85

WELL PURPOSE: Home
 (home, irrigation, municipal, industrial)

WELL COMPLETION DATA:

(1) diameter (inches) 4

(2) total depth (feet) 95

(3) static water level (feet) 65 below top of ground.

(4) casing pl. 95
 (material) (depth)
4" if telescope see back.
 (size)

(5) screen 6 89
 (length) (depth to top)
4" (size) pl. (material)

(6) pump 1/2 10
 (HP) (yield gpm)
Electric
 (type power)

(7) electric log _____
 (yes or no)

 (organization running log)

(8) how well bottom plugged wood

CODED


MAR 19 1970

MISS. BD. OF
 WATER COMM.

DRILLERS REMARKS:

If well telescopes please sketch and show depths.

GROUND LEVEL

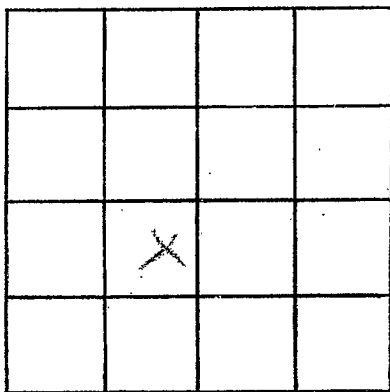

SECTION 5

Please indicate well location X.

ADDITIONAL INFORMATION

If more than one screen,
show locations of each on sketch.