

Pike
 CTB5
 4-29-70

MISSISSIPPI
 BOARD OF WATER COMMISSIONERS
 416 North State Street
 Jackson, Mississippi 39201

WATER WELL DRILLERS LOG

4-29 1970 Fitzgerald Well Dr Pike
 date well completed firm name county well located

LANDOWNER:
Jehon Journey
RR. Jaynes Miss
 (mailing address)

description of formations encountered	from	to
<u>Red Clay</u>	<u>0</u>	<u>20</u>
<u>Red sand</u>	<u>20</u>	<u>60</u>
<u>Red gravel</u>	<u>60</u>	<u>100</u>
<u>Red sand</u>	<u>100</u>	<u>125</u>
<u>Coarse sand & gravel</u>	<u>125</u>	<u>140</u>

WELL LOCATION:
 sec. 11 T 4 N R 9 029
6 miles N of Prichard
 (distance) (direction) (nearest town)

WELL PURPOSE: Home
 (home, irrigation, municipal, industrial)

WELL COMPLETION DATA:

(1) diameter (inches) 4

(2) total depth (feet) 140

(3) static water level (feet) 90 below above top of ground.

(4) casing Alaska, 132,
 (material) (depth)
4 if telescope see back.
 (size)

(5) screen 8, 132
 (length) (depth to top)

4, Alaska
 (size) (material)

(6) pump 1, 6
 (HP) (yield gpm)

Elm
 (type power)

(7) electric log no
 (yes or no)

(organization running log)


(8) how well bottom plugged woodpe

DRILLERS REMARKS:

MAY 28 1970
 MISS. Bd. of
 WATER COMMISSIONERS

If well telescopes please sketch and show depths.

GROUND LEVEL

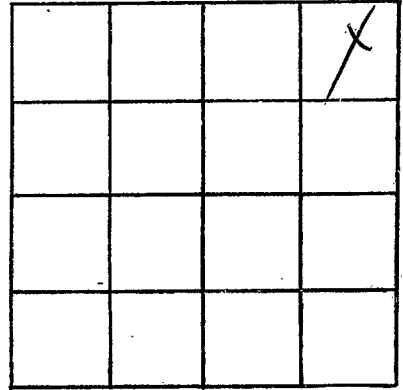

SECTION 11

Please indicate well location X.

ADDITIONAL INFORMATION

If more than one screen,
show locations of each on sketch.