

MISSISSIPPI
 BOARD OF WATER COMMISSIONERS
 416 North State Street
 Jackson, Mississippi 39201

CODED

WATER WELL DRILLERS LOG

Pike
C36
6-26-70

6-26 1970 Fitzgerald Well Dr Pike
 date well completed firm name county well located

LANDOWNER:
Walter River
R.R. Summitt & Son
 (mailing address)

description of formations encountered	from	to
<u>Red Clay</u>	<u>0</u>	<u>20</u>
<u>Fine Sand</u>	<u>20</u>	<u>90</u>
<u>Coarse Sand</u>	<u>90</u>	<u>111</u>

WELL LOCATION:
 sec. 17 T. 4 N. R. 9 E
8 miles ENE of 20th Comb
 (distance) (direction) (nearest town)

WELL PURPOSE: Home
 (home, irrigation, municipal, industrial)

- WELL COMPLETION DATA:
- (1) diameter (inches) 4
 - (2) total depth (feet) 111
 - (3) static water level (feet) 45 below top of ground.
 - (4) casing Galv 103
 (material) (depth)
4 if telescope see back.
 (size)
 - (5) screen 8 103
 (length) (depth to top)
4 (size) Galv (material)
 - (6) pump 1/2 12
 (HP) (yield gpm)
el (type power)
 - (7) electric log no
 (yes or no)
- (organization running log)
- (8) how well bottom plugged wood plug

CODED


DRILLERS REMARKS:

JUL 24 1970

MISS. BD. OF
 WATER COMM.

If well telescopes please sketch and show depths.

GROUND LEVEL

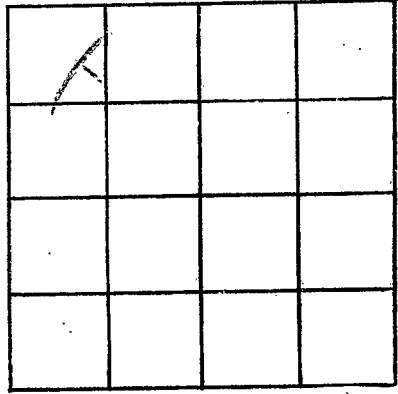

SECTION 17

Please indicate well location X.

ADDITIONAL INFORMATION

Lined area for additional information.

If more than one screen, show locations of each on sketch.