

Pike  
 C 37  
 7-18-70

MISSISSIPPI  
 BOARD OF WATER COMMISSIONERS  
 416 North State Street  
 Jackson, Mississippi 39201

**CODED**

WATER WELL DRILLERS LOG

July 18 1970 chester keeles Pike  
 date well completed firm name county well located

LANDOWNER: Department #4

description of formations encountered	from	to
	Red clay	0
Red sand	22	71
Chalk & gravel	71	130
Small gravel	130	143

RFD Hayes  
 (mailing address)

WELL LOCATION:

sec. 10 T. 4 N. R. 9 E  
3 miles N Presdale  
 (distance) (direction) (nearest town)

WELL PURPOSE: Home  
 (home, irrigation, municipal, industrial)

WELL COMPLETION DATA:

- (1) diameter (inches) 4"
- (2) total depth (feet) 143
- (3) static water level (feet) 97 below top of ground
- (4) casing Plastic Bottom  
 (material) (depth)
- (size) If telescope see back.
- (5) screen 6' 137'  
 (length) (depth to top)
- 4" Plastic  
 (size) (material)
- (6) pump 1/2 sub 10  
 (HP) (yield gpm)
- Elect.  
 (type power)
- (7) electric log No.  
 (yes or no)

**CODED**

(organization running log)


(8) how well bottom plugged wooden plug

DRILLERS REMARKS: new location

JUL 27 1970

If well telescopes please sketch and show depths.

GROUND LEVEL

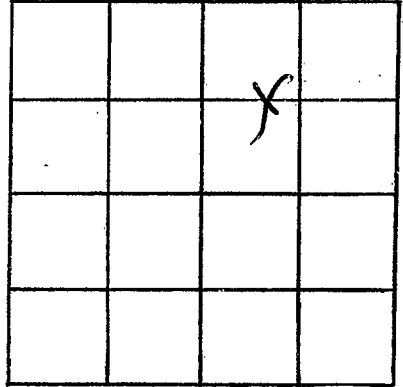

SECTION 10

Please indicate well location X.

ADDITIONAL INFORMATION

If more than one screen,  
show locations of each on sketch.