

PIKE  
C 39  
11-19-70

MISSISSIPPI  
BOARD OF WATER COMMISSIONERS  
416 North State Street  
Jackson, Mississippi 39201

**CODED**

WATER WELL DRILLERS LOG

11-19-70 date well completed      1970 firm name *Fitzgerald*      *Perle* county well located

LANDOWNER:	description of formations encountered	from	to
<i>Merton Boyd</i>	<i>Red Clay</i>	0	20
<i>R.R. [unclear] [unclear]</i> (mailing address)	<i>Fire Shale</i>	20	60
	<i>Coarse Sand</i>	60	66
<b>WELL LOCATION:</b>			
sec. <u>34</u> T <u>4</u> N R <u>9</u> E			
<u>1</u> miles <u>S</u> of <u>Prichard</u> (distance) (direction) (nearest town)			
<b>WELL PURPOSE:</b> <u>Home</u> (home, irrigation, municipal, industrial)			
<b>WELL COMPLETION DATA:</b>			
(1) diameter (inches) <u>4</u>			
(2) total depth (feet) <u>66</u>			
(3) static water level (feet) <u>20</u> below above top of ground.			
(4) casing <u>Plaster</u> , <u>60</u> (material) (depth)			
<u>4</u> if telescope see back. (size)			
(5) screen <u>6</u> , <u>60</u> (length) (depth to top)			
<u>4</u> , <u>Plaster</u> (size) (material)			
(6) pump <u>1/2</u> , <u>15</u> (HP) (yield gpm)			
<u>Electric</u> (type power)			
(7) electric log <u>yes</u> (yes or no)			
(8) how well bottom plugged <u>well</u>			
<b>DRILLERS REMARKS:</b>			


**CODED**

DEC 17 1970

MISS. BD. OF  
WATER  
COMMISSIONERS

If well telescopes please sketch and show depths.

GROUND LEVEL

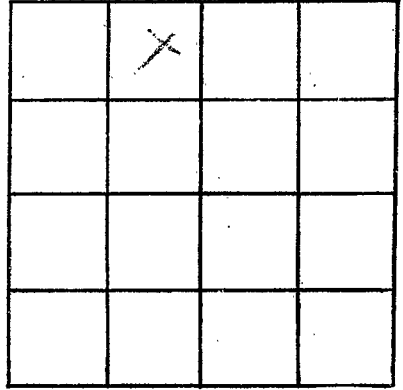

SECTION 34

Please indicate well location X.

ADDITIONAL INFORMATION

If more than one screen,  
show locations of each on sketch.