

12-22-70

MISSISSIPPI  
BOARD OF WATER COMMISSIONERS  
416 North State Street  
Jackson, Mississippi 39201

**CODED**

# WATER WELL DRILLERS LOG

12-22  
date well completed

1970 Fitzgerald  
firm name

Pike  
county well located

**LANDOWNER:**

Larry Morgan

RR Jones Miss.  
(mailing address)

## WELL LOCATION:

sec. 33 T 4 N S R 9 E W  
2 miles E of Prineville  
(distance) (direction) (nearest town)

**WELL PURPOSE:**

(home, irrigation, municipal, industrial)

**WELL COMPLETION DATA:**

- (1) diameter (inches) 4
- (2) total depth (feet) 135
- (3) static water level (feet) 75 below  
top of ground.
- (4) casing Plastic 129,  
(material) (depth)  
4 if telescope see back.  
(size)
- (5) screen 6 129  
(length) (depth to top)  
4 Plastic  
(size) (material)
- (6) pump 1/2 9  
(HP) (yield gpm)  
Electric  
(type power)
- (7) electric log Yes  
(yes or no)

(organization running log)

- (8) how well bottom plugged Wheel free

**DRILLERS REMARKS:**

**description of formations encountered**

from

to

Reel Clow

Real Fine

Course Southward

Reel Land

Course level & ground

**CODED**


JAN 21 1977

1945. 05, 07

~~SECRET~~ ~~CONFIDENTIAL~~

If well telescopes please  
sketch and show depths.

GROUND LEVEL

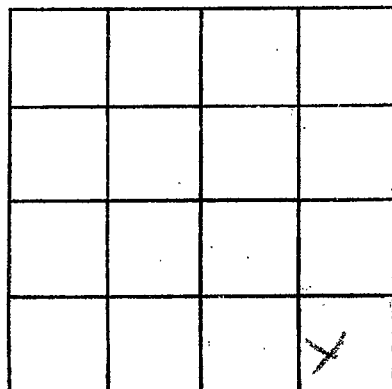

SECTION 28

Please indicate well location X.

ADDITIONAL INFORMATION

If more than one screen,  
show locations of each on sketch.